


T.17S.,R.3W.,W.M.

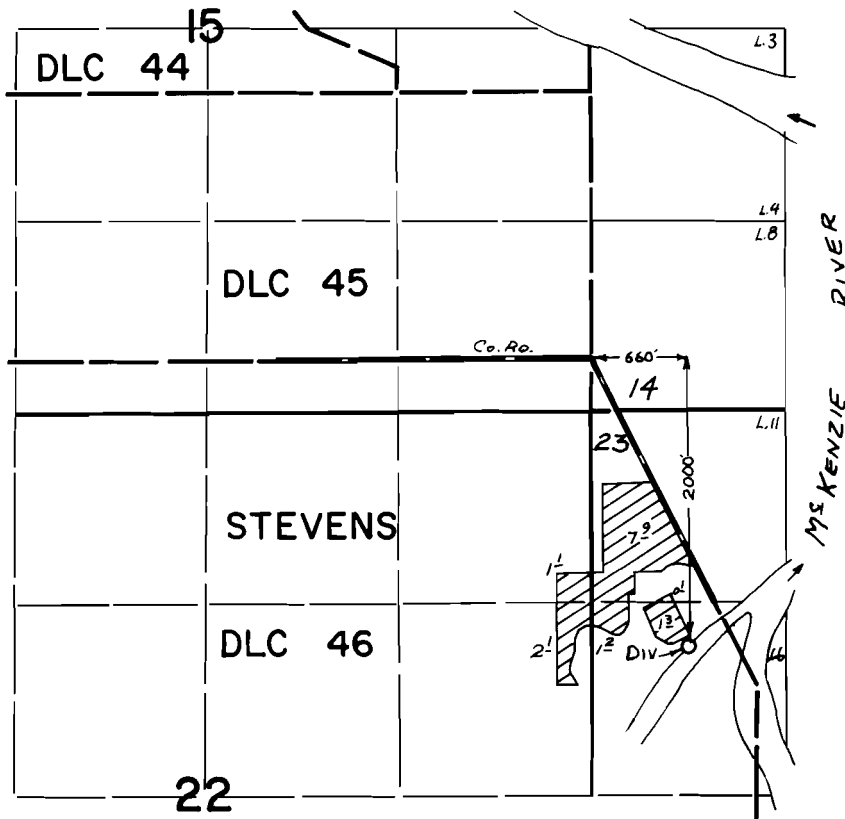

FINAL PROOF SURVEY UNDER

Application No. 55544 Permit No. 41975.....
IN NAME OF

HARRY A. PURVINE.....

Surveyed May 3, 1982, by L. M. TOLL.....