


T. 26 & 27 S., R. 3 & 4 W., W.M.

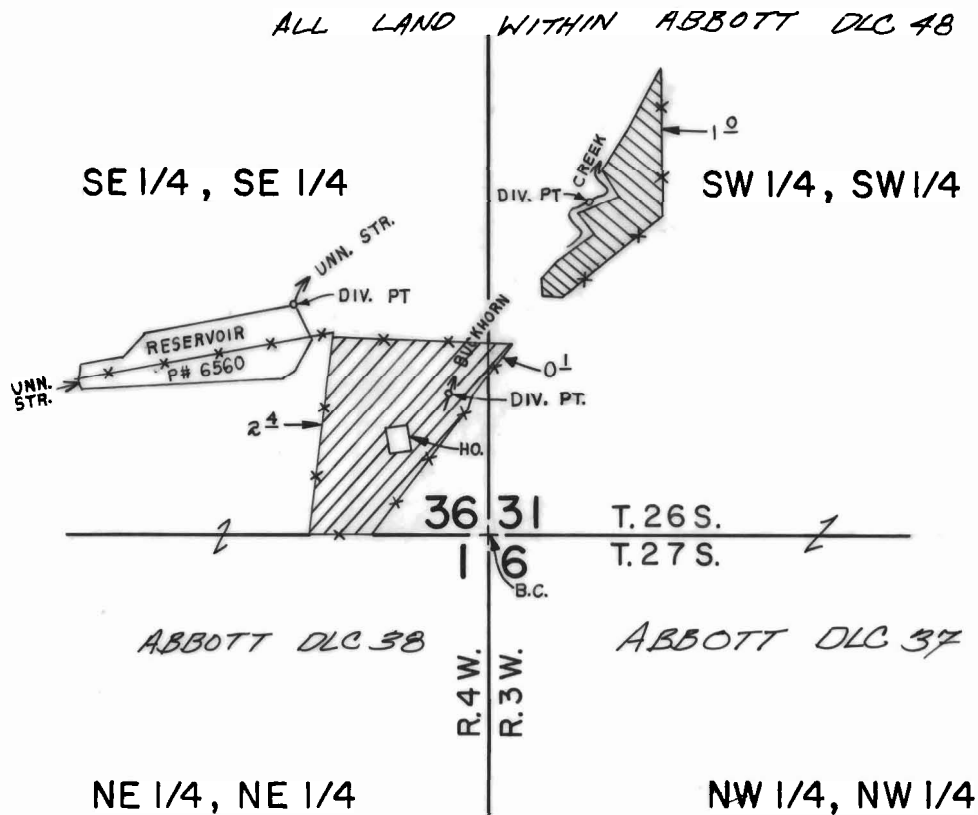

DIV. PT. #1 P# R-6560 LOCATED 480' N. & 405' W. FROM S.E. COR. SEC. 36
 DIV. PT. #2 P# 41227 LOCATED 295' N. & 85' W. FROM S.E. COR. SEC. 36
 DIV. PT. P# 44073 LOCATED 695' N. & 210' E. FROM S.E. COR. SEC. 36

▨ P# 41227
 ▨ P# 44073

SCALE: 1" = 400'

FINAL PROOF SURVEY UNDER

R-55011 R-6560
 55076 41227
 Application No. 58334 Permit No. 44073
 IN NAME OF

ELBERT L. PYLE

Surveyed AUG. 29, 1984, by L. CASHION