


T. 26 & 27 S., R. 3&4 W., W.M.

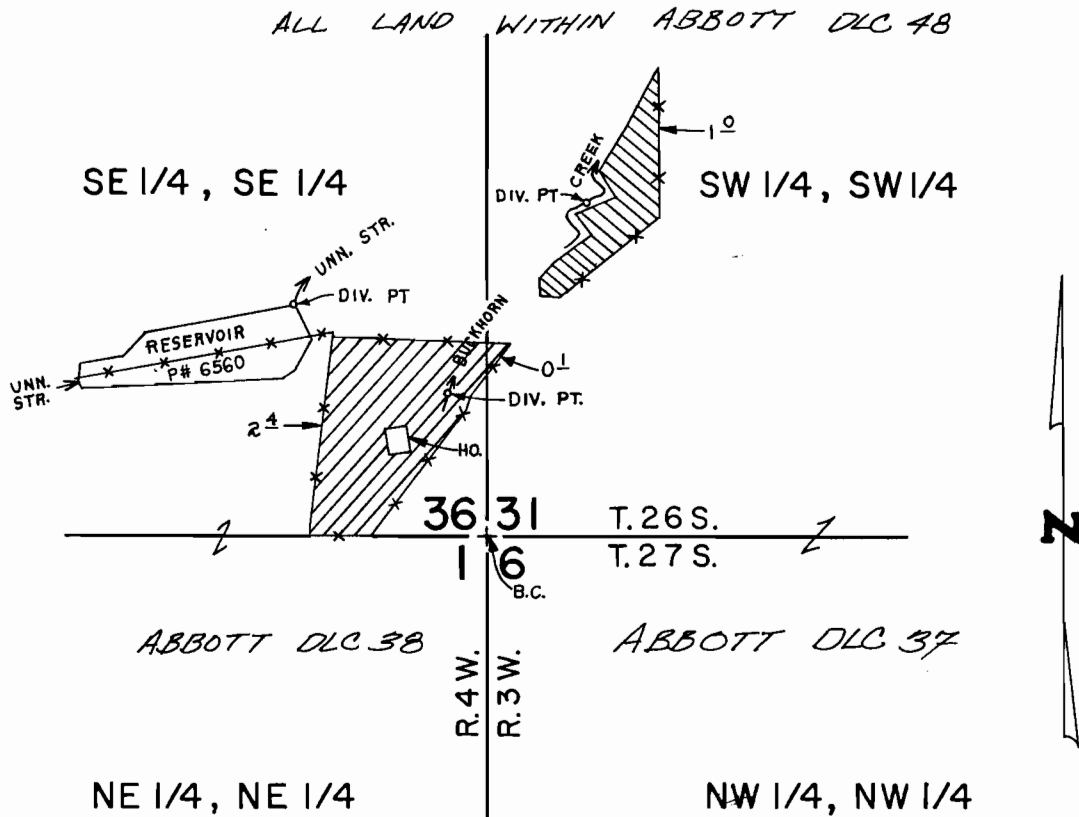

DIV. PT. #1	P# R-6560	LOCATED 480'N. & 405'W.	FROM S.E. COR.	SEC. 36
DIV. PT. #2	P# 41227	LOCATED 295'N. & 85'W.	FROM S.E. COR.	SEC. 36
DIV. PT. #3	P# 44073	LOCATED 695'N. & 210'E.	FROM S.E. COR.	SEC. 36

 P# 41227
 P# 44073

SCALE: 1"=400'

FINAL PROOF SURVEY

UNDER

R-55011 R-6560
 55076 41227
 Application No. 58334 Permit No. 44073
 IN NAME OF

ELBERT L. PYLE

Surveyed AUG. 29, 1984 by L. CASHION