


T. 39 S., R. 5 W., W.M.

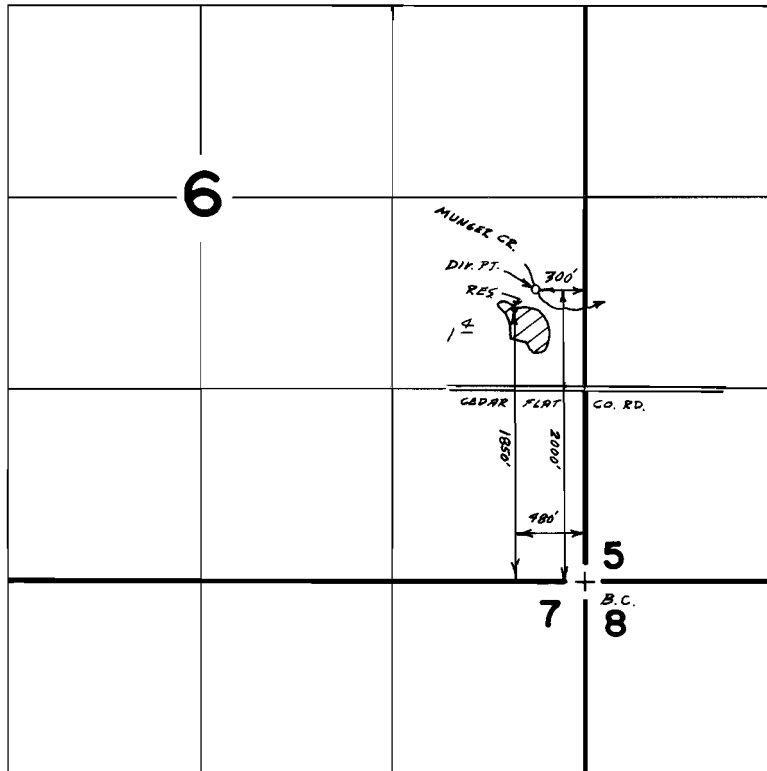

Scale 1"=1320'

FINAL PROOF SURVEY UNDER

R-54800 R-6547

Application No. 54801.. Permit No. 41085.....

IN NAME OF

LLOYD D. & JACQUELINE D. REEDER

Surveyed Aug...15., 19.84, by B.S. JAMES.....