


G-6620

57821
57838

T. 4S., R. 24E., W. M.

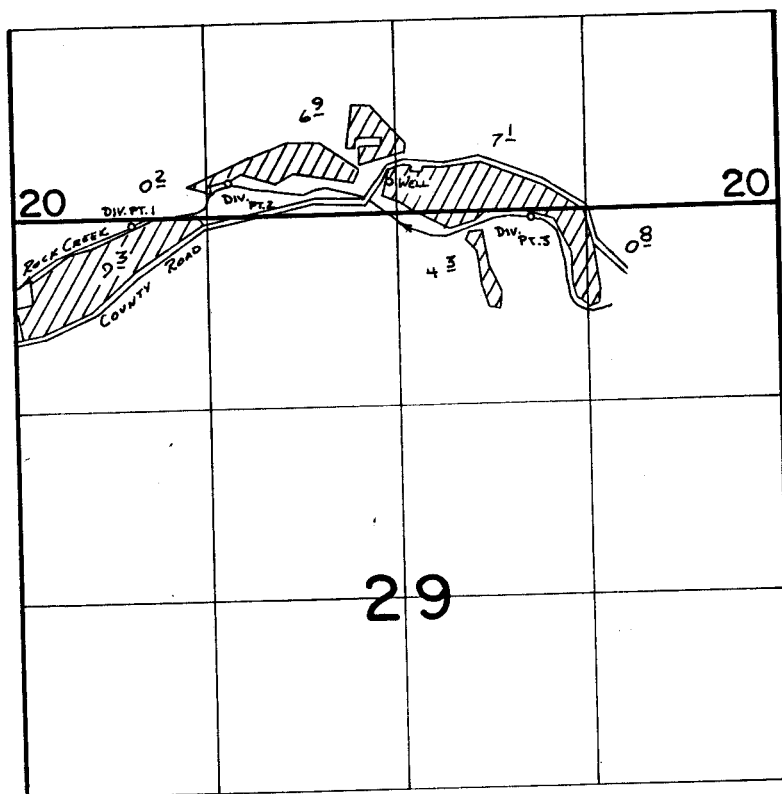

WELL LOC: 200' N. & 50' W. FROM S 1/4 COR. SECTION 20
DIV. PT. 1 LOC: 50' S. & 810' E. FROM NW COR. SECTION 29
DIV. PT. 2 LOC: 230' N & 1490' E FROM SW COR. SECTION 20
DIV. PT. 3 LOC: 45' S. & 3590' E FROM NW COR. SECTION 29

SCALE: 1" = 1320'

FINAL PROOF SURVEY UNDER

G-7189 G-6620
Application No. 53812... Permit No. 40172.....
IN NAME OF

...ROBERT G. VAN SCHOLACK.....

Surveyed 5:18..... 1978., by R.E. Barwin.....

RES. 7/2/84
PTS-1978-P-C V.L.S.