



T.32 & 33S., R.2 & 3E., W.M.

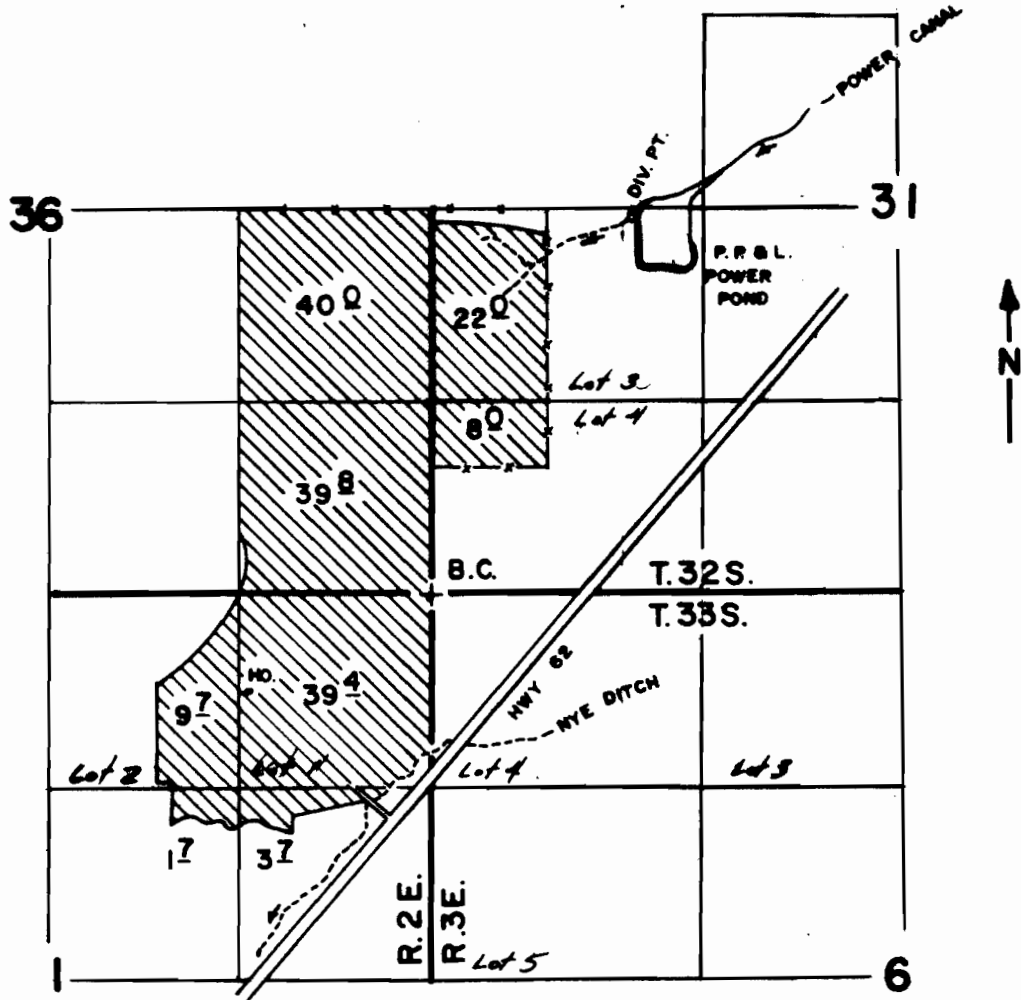

SCALE 4" = 1 MILE

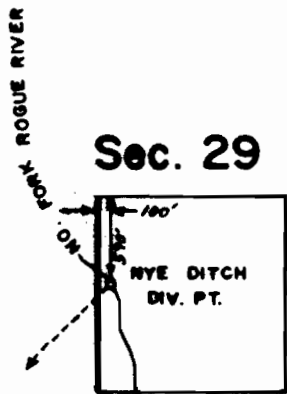

Sec. 29

NW 1/4 SW 1/4

FINAL PROOF SURVEY UNDER

Application No. 62062 50108... Permit No. 46021 37415.....
IN NAME OF

.....RALPH B. or ANNABELLE LEIBY

Surveyed May..23, 1983, by B.S. JAMES.....