


T. 10S., R. 1E., W. M.

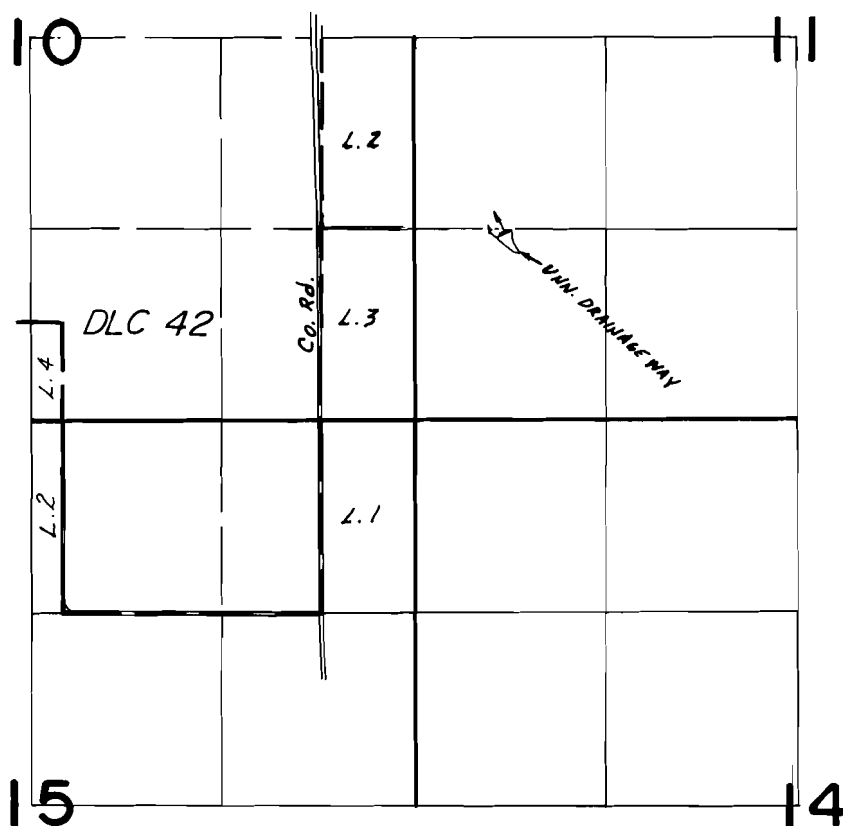

DIV. PT. LOC. 1300' N. & 600' E. FROM SW COR. SEC. 11

FINAL PROOF SURVEY
UNDER

R-56383 R-6638
Application No. 56384 Permit No. 41967.....
IN NAME OF

.....S. L. SILBERNAGEL.....

Surveyed JUNE 9, 1982, by L. M. TOLL.....