


T. 1 N., R. 42 E., W.M.

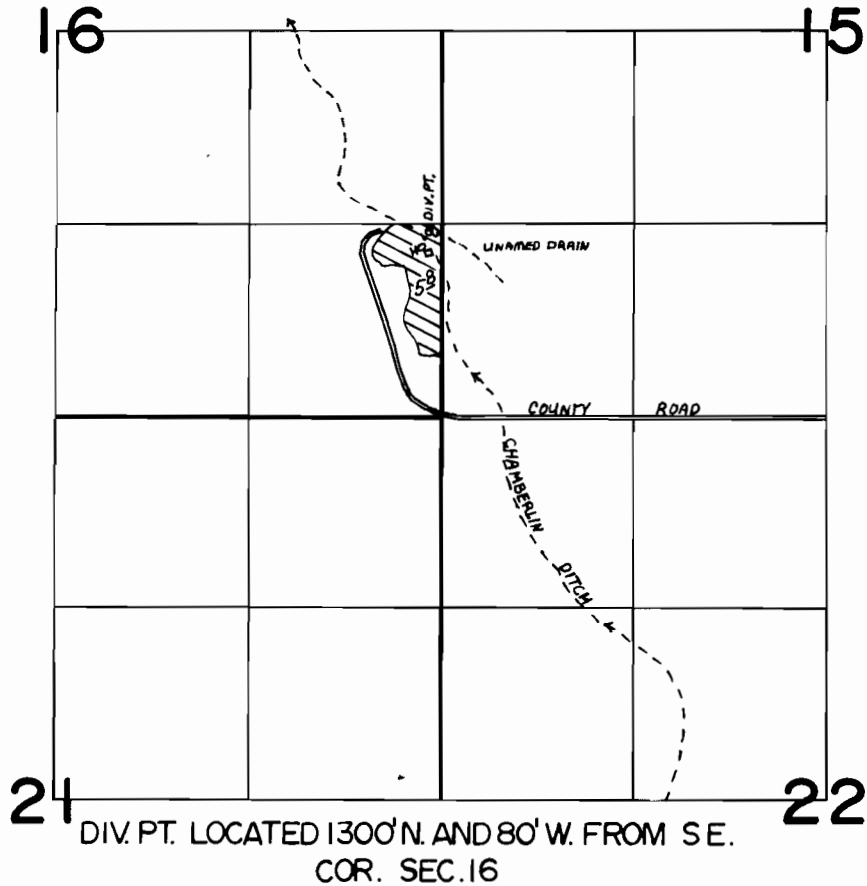

SCALE: 1"=1320'



FINAL PROOF SURVEY UNDER

Application No. 55254 Permit No. 41474
IN NAME OF

LON. B. SKJEI

Surveyed Aug. 13.... 1985., by V.L. CHURCH.....