


T. 26 S., R. 2 W., W.M.

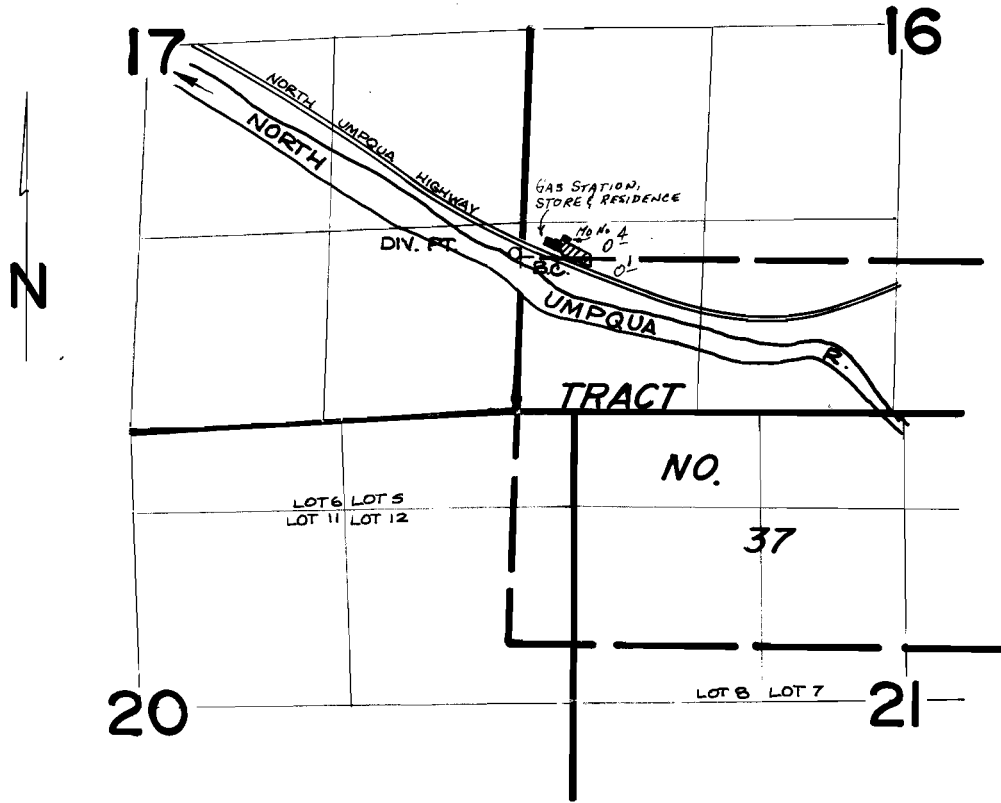

DIV. PT. IS LOCATED 40' N. & 40' W. OF NW CORNER OF TRACT #37

SCALE : 4" = 1 MILE

FINAL PROOF SURVEY UNDER

Application No. ..53083. Permit No.40316.....
IN NAME OF

.....PHILLIP...D...WEBB.....

Surveyed .OCT...8... 19..86, by ...J.M...SCHMORDE..