


T. 40 S., R. 8 W., W.M.

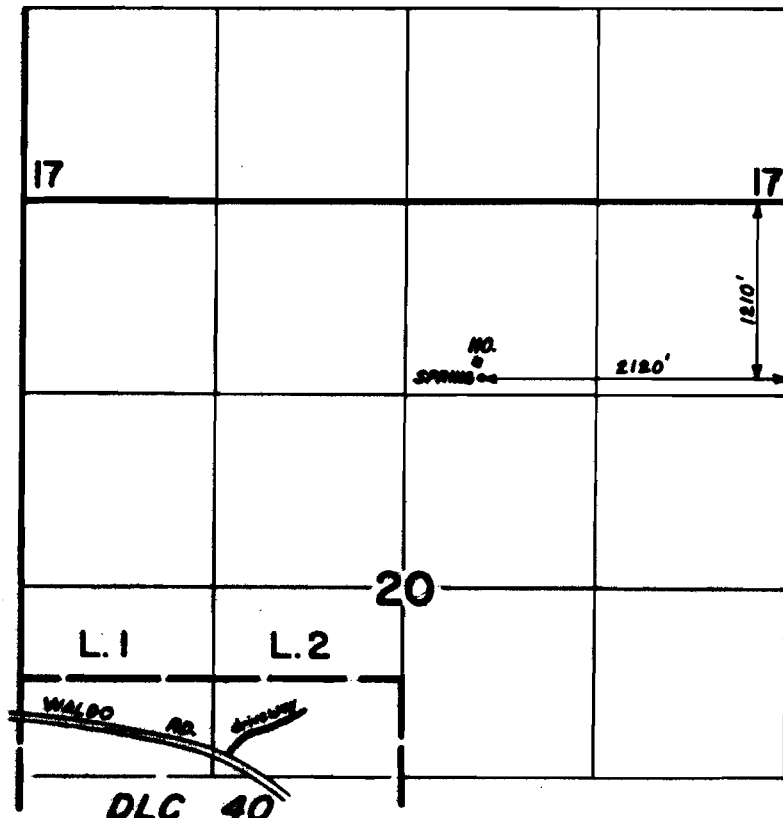

Scale: 4" = 1 mile

FINAL PROOF SURVEY UNDER

Application No. **55893** Permit No. **41921**.....
IN NAME OF

.....
Surveyed **MAR. 26 19.84**, by **B. S. JAMES**.....