


T.1N. & 1S., R.4E., W.M.

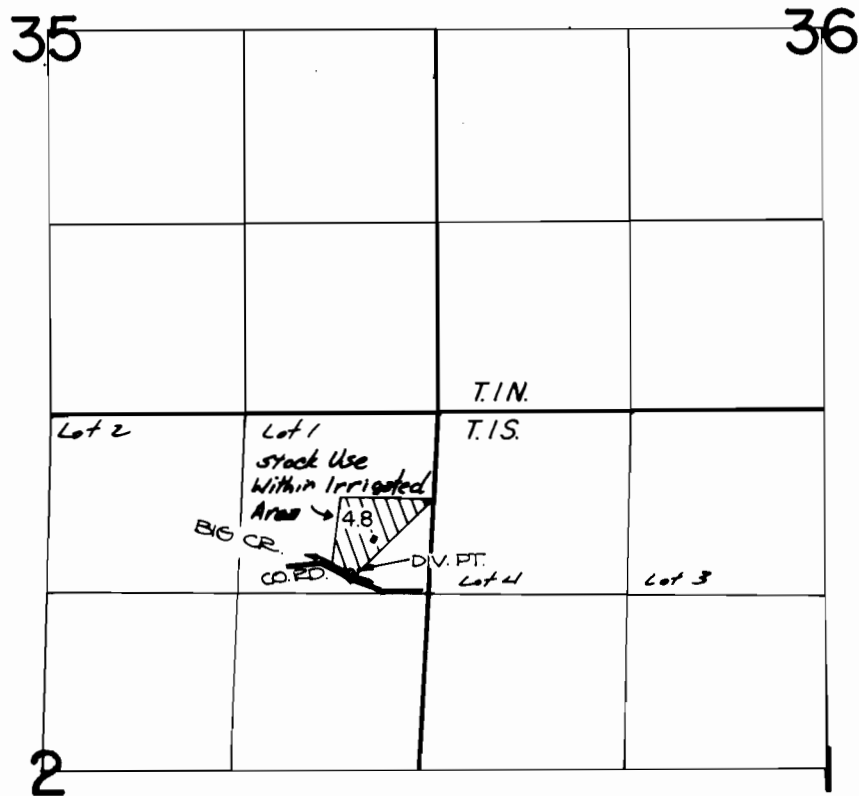

DIV. PT. LOCATION: 1090 FT. S. AND 600 FT. W. FROM THE N.E. CORNER OF SECTION 2.

FINAL PROOF SURVEY UNDER



SCALE: 4" = 1 MILE

Application No. 54547... Permit No. 40933.....
IN NAME OF

ALAN L. & SHIRLEY E. STOKES

Surveyed MAY 1, 1984, by P. Paster