


T.19S., R.33&33 1/2 E., W.M.

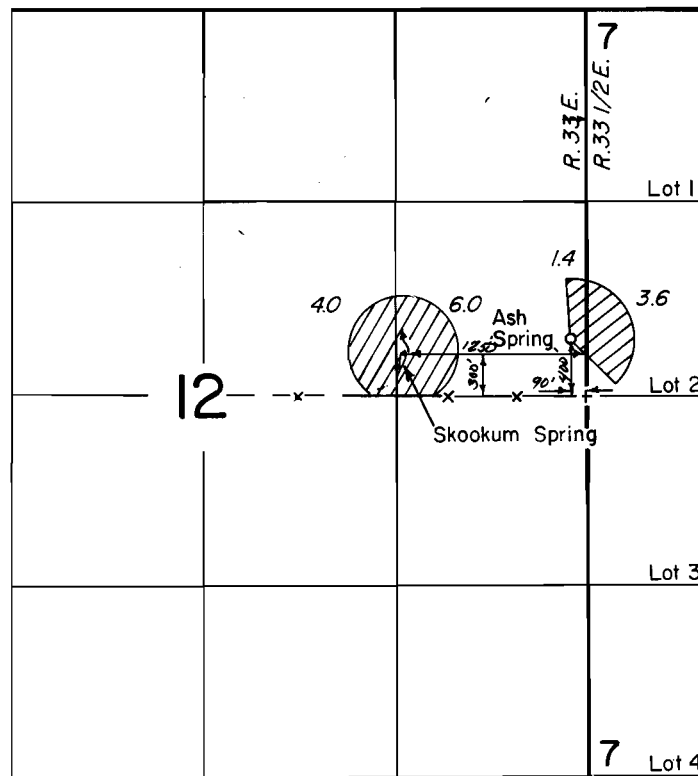

FINAL PROOF SURVEY
UNDER

Application No. 55392. Permit No. 42345...
IN NAME OF

J. ARNOLD & D. A. DOMAS

Surveyed JULY 15, 1980, by *dlb*