


T.12S., R.1W., W.M.

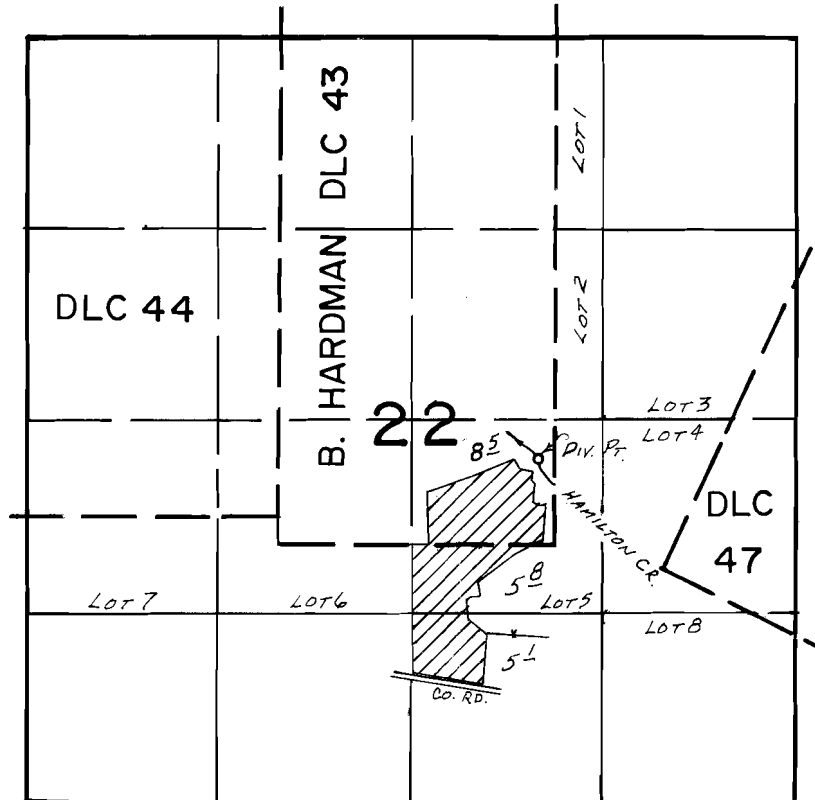

DIV. PT. LOC: 5°30' N 4°18'30" E FROM SW. COR. B. HARDMAN DLC 43.

FINAL PROOF SURVEY UNDER

Application No. 55812... Permit No. 41785.....
IN NAME OF

.....CHARLIE C. TERRILL.....

Surveyed MAY 24... 1982, by L.M. TOLL.....