


T.5S., R.9W., W.M.

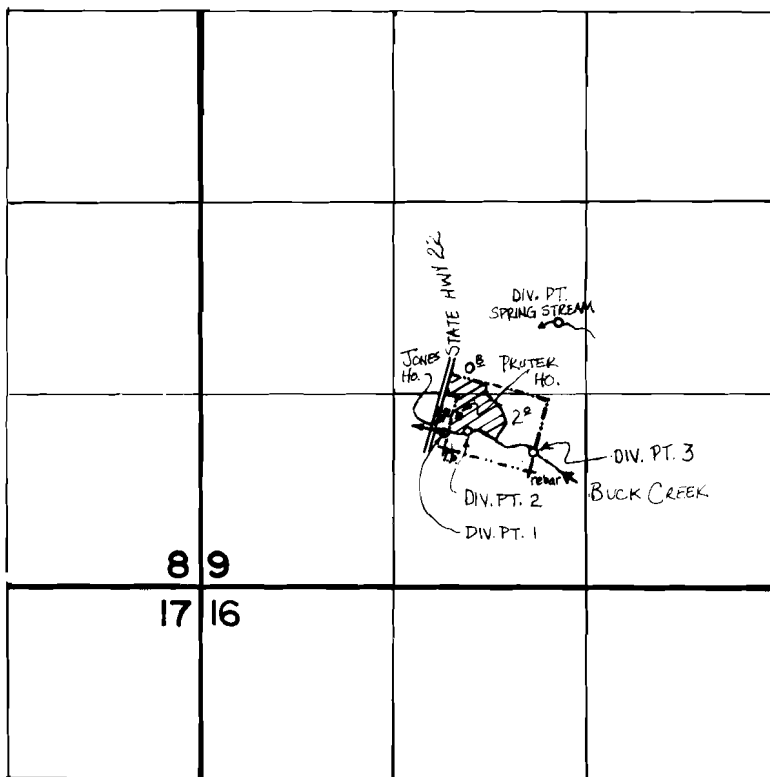

LOCATIONS FROM SW. COR. SEC. 9:
 SPRING STREAM DIV. PT. - 1810' N. & 2440' E.
 DIV. PT. 1 - 1060' N. & 1650' E.
 DIV. PT. 2 - 1070' N. & 1810' E.
 DIV. PT. 3 - 930' N. & 2260' E.

FINAL PROOF SURVEY UNDER

Application No. **55614** Permit No. **41668**...
 IN NAME OF

JOHN P. & JANE JONES, MARY NEWHOUSE & LOWELL PRUTER

Surveyed **NOV. 4** 1983, by **M. CAHILL**.....