


T.13S. R.11W. W.M.

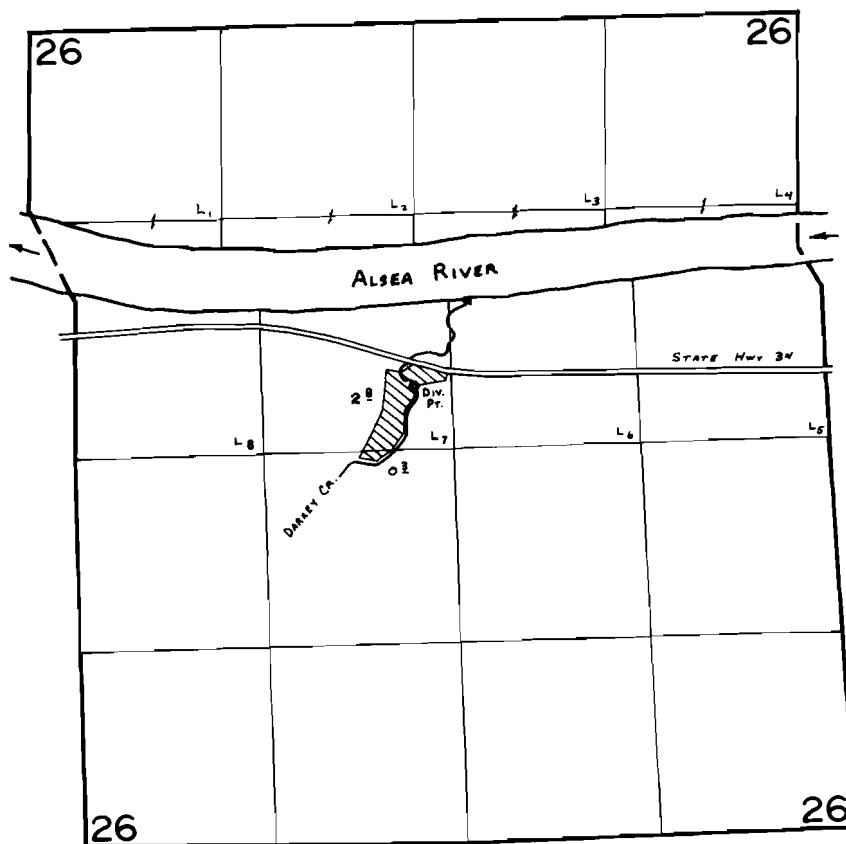

Div. Pt. Loc: 420' N. & 270' W. fr. C. 1/4 Cor. Sec. 26.

FINAL PROOF SURVEY
UNDER

Application No. 54075 Permit No. 40711.....
IN NAME OF

LARRY E. TRYON.....

Surveyed May 21, 1980, by C. L. Hughes.....