


T.13S., R.27E., W.M.

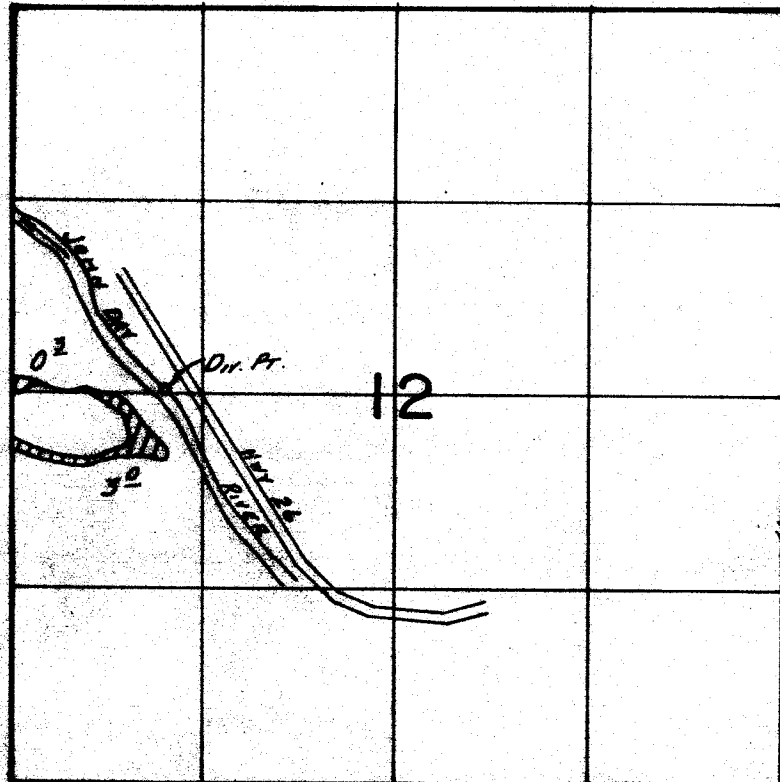

Div. Pt. Loc.: 30' N. & 1060' E. FROM N $\frac{1}{4}$ COR. SEC. 12.

SCALE: 1" = 1320'

FINAL PROOF SURVEY
UNDER

Application No. 47031... Permit No. 41360.....
IN NAME OF

.....ROBERT BITTER.....

Surveyed Aug. 9..... 19.84, by P. PASTER.....