T. 38S., R1W., W.M.

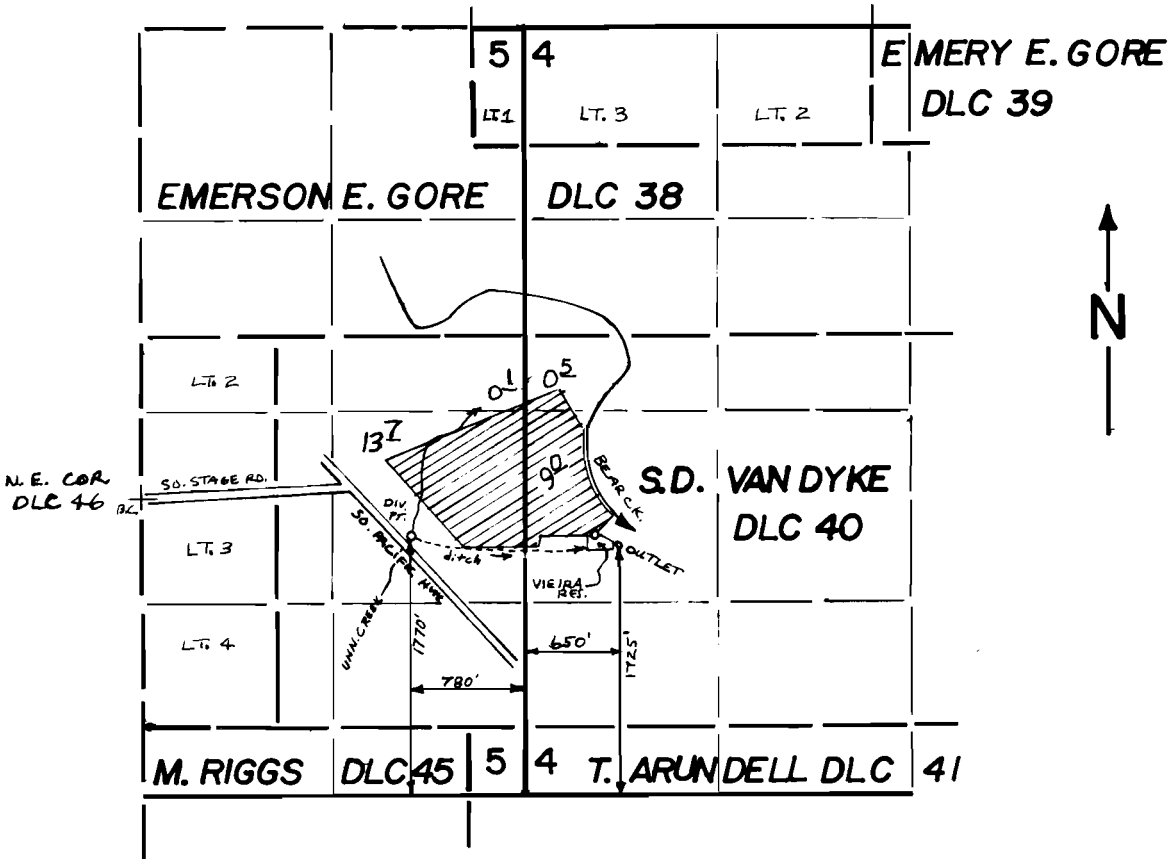

T. 36 S., R. 2E., W.M.

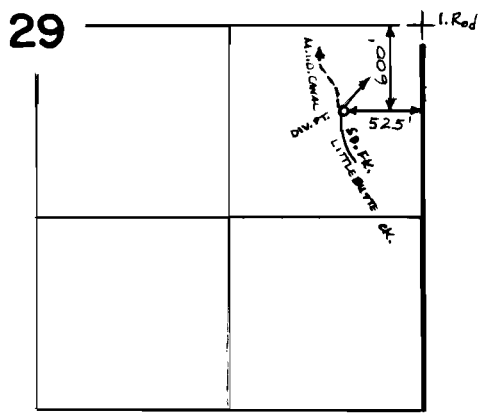

SCALE : 1" = 1320'

FINAL PROOF SURVEY

UNDER

54461 40834

R-54460 R-6512

Application No. ..... Permit No. .....

IN NAME OF

LINO S. VIEIRA

Surveyed MAR. 22 19 84, by B.S. JAMES

41029-279-241 R J.R.W.