



T. 38 S., R. 1 W., W. M.

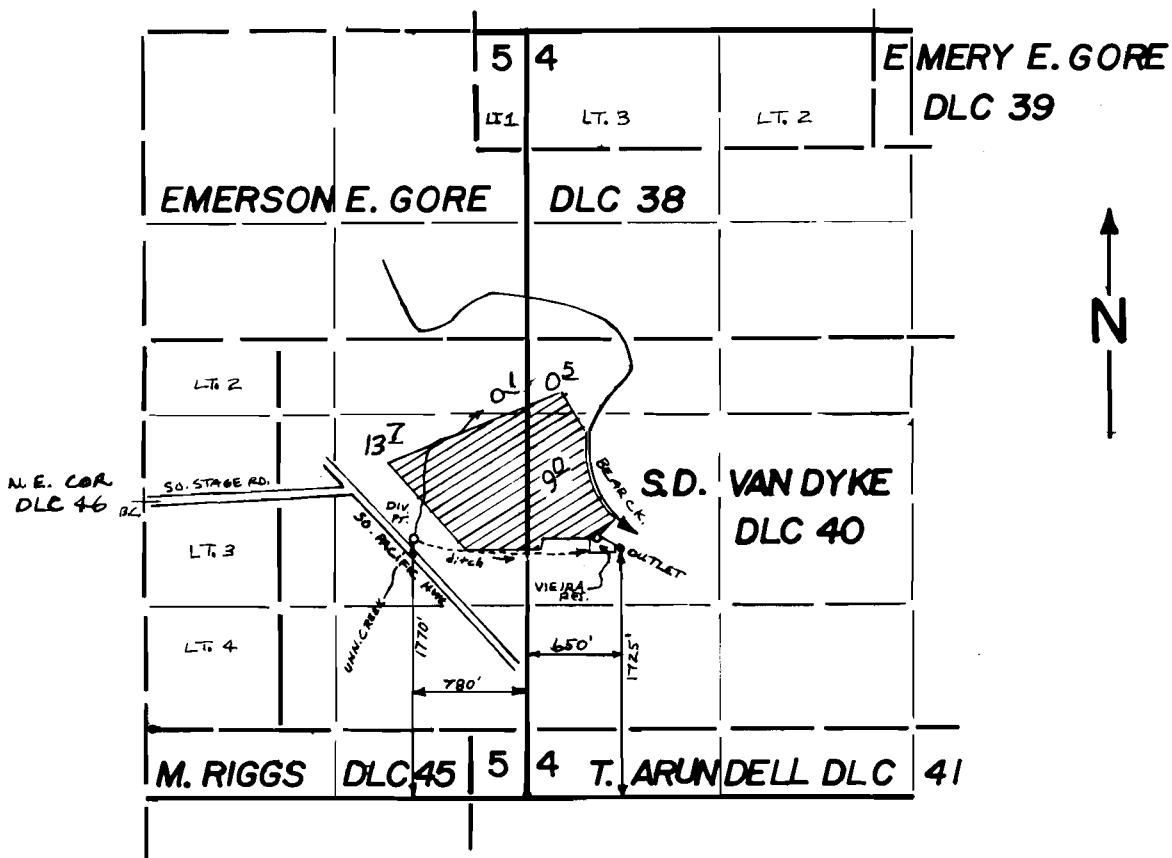

T. 36 S., R. 2 E., W. M.

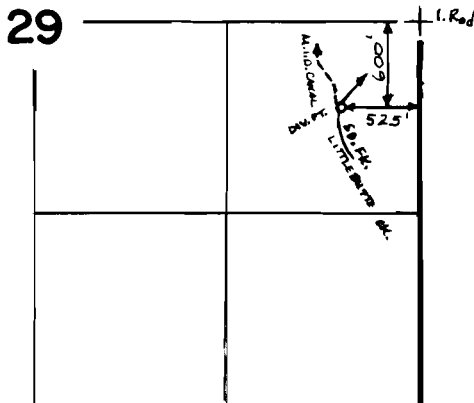

SCALE: 1" = 1320'
FINAL PROOF SURVEY
UNDER

54461

R-54460

Application No.

IN NAME OF

LINO S. VIEIRA

Surveyed MAR. 22 84 by B. S. JAMES