


T. 8S., R. 4 & 5W., W.M.

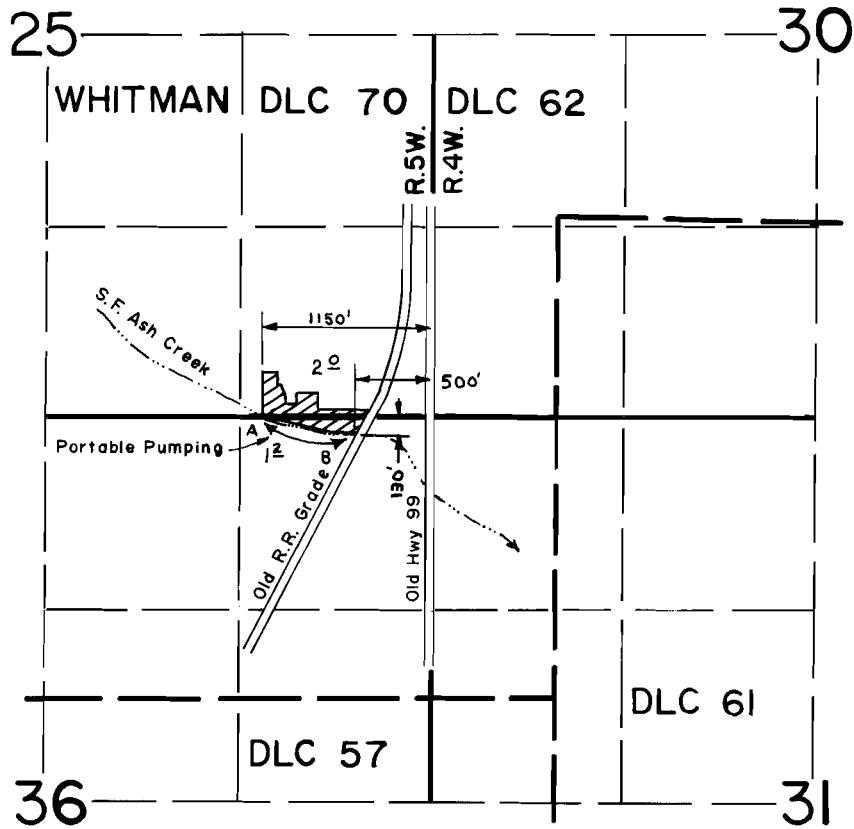

SCALE: 1" = 1320'

**FINAL PROOF SURVEY**  
UNDER

Application No. 56026 Permit No. 41944  
IN NAME OF

**FRED C. & LENA M. VOIGT**

Surveyed AUG 10 1983, by L. TOLL