


# T.5S. R.3W. W.M.

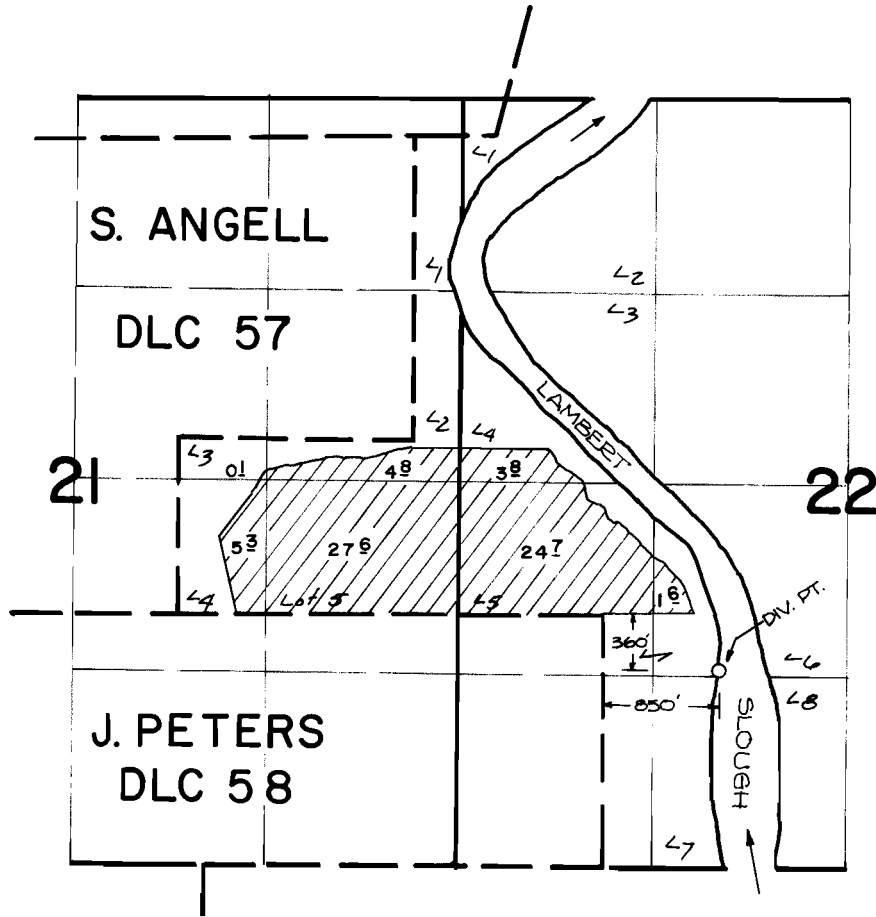

## FINAL PROOF SURVEY UNDER

Application No. 55200 Permit No. 41531....  
IN NAME OF

**EDITH.....LORRAINE.....YUNGEN**

Surveyed **SEPT. 28, 1983**, by *P. Pagter*.....