


T.20S. R.3W. W.M.

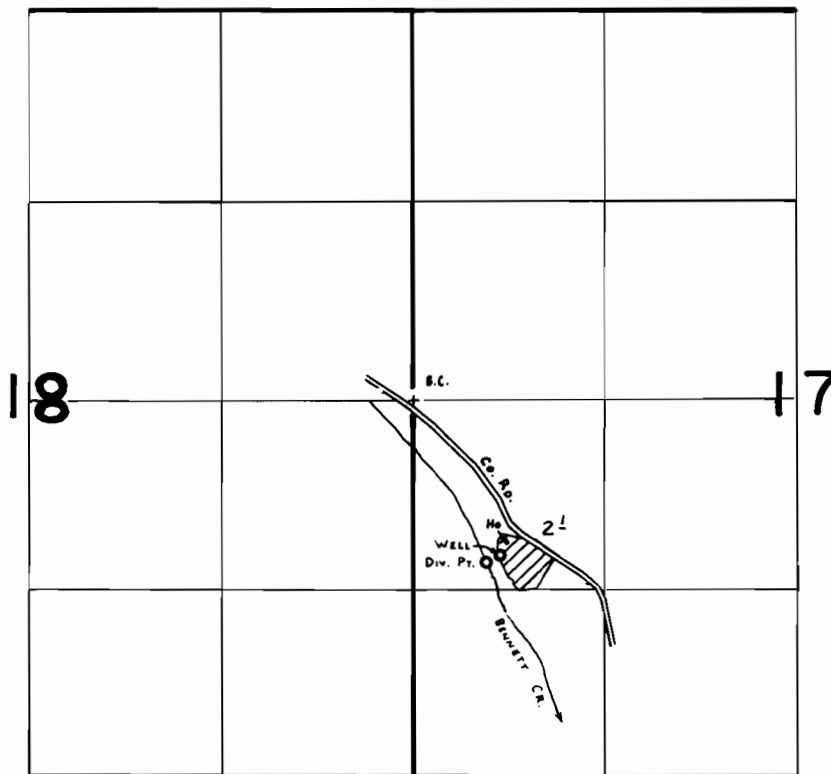

DIV. PT. LOC: 1110'S & 500'E } BOTH FROM W. 1/4 COR. SEC. 17.
WELL LOC: 1060'S & 600'E }

FINAL PROOF SURVEY
UNDER

G-6363 G-5960
Application No. 51531... Permit No. 38619.....
IN NAME OF

.....**JOHN C. BUGLEY**.....

Surveyed May...23... 1979, by ...C.L. HUGHES...