


T.11S. R.2W. W.M.

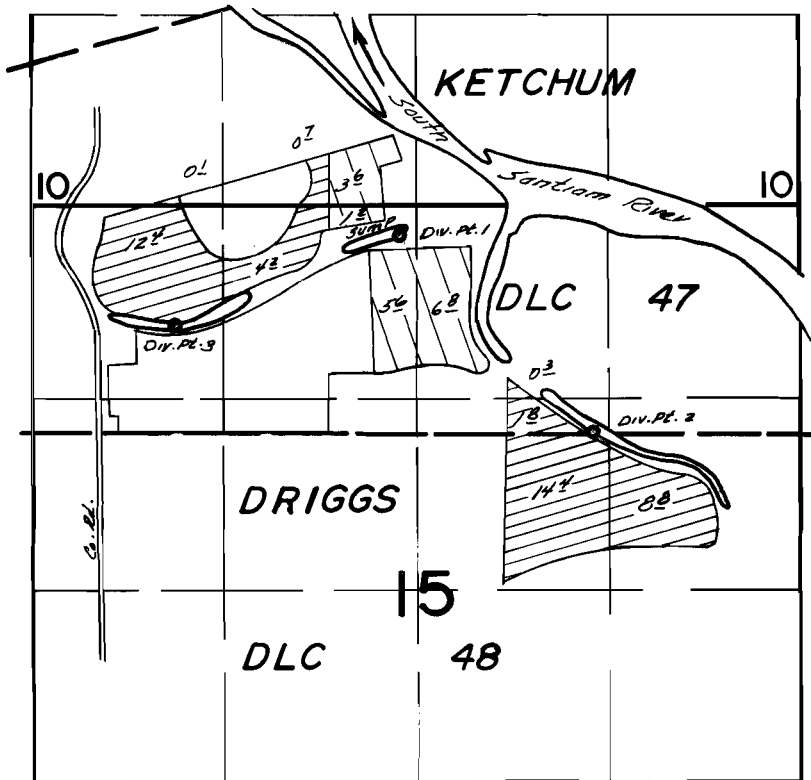

Div. Pl. 1 - 208'5" x 120' W.
 Div. Pl. 2 - 1546'5" x 1210' E.
 Div. Pl. 3 - 820'5" x 1650' W.

} All from N¹/₄ Cor. Sec. 15

FINAL PROOF SURVEY UNDER

Application No. 53092 Permit No. 39924
 G-6936 G-6454...

IN NAME OF

ROBERT F. & ISABEL R. MEYER

Surveyed MAY...J.... 1979., by S.C.BROWN.....