


T.11S. R.2W. W.M.

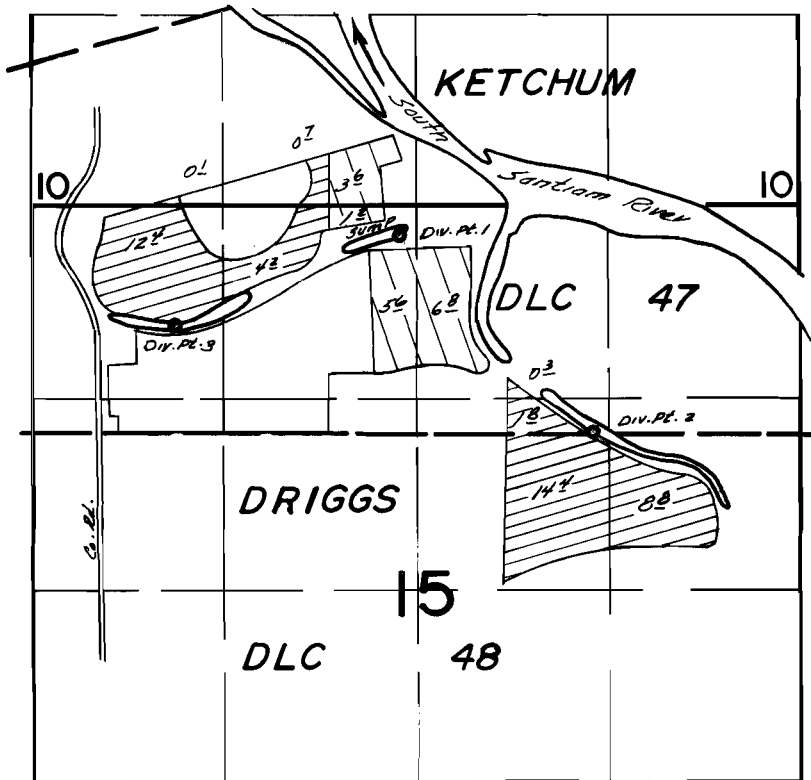

Div. Pt. 1 - 208' S $\frac{1}{2}$ 120' W.
Div. Pt. 2 - 1546' S $\frac{1}{2}$ 1210' E.
Div. Pt. 3 - 820' S $\frac{1}{2}$ 1650' W. } All from N $\frac{1}{4}$ Cor. Sec. 15

FINAL PROOF SURVEY
UNDER

Application No. 53092 Permit No. 39924
G-6936 G-6454...
IN NAME OF

ROBERT F. & ISABEL R. MEYER

Surveyed MAY...J.... 1979., by S.C.BROWN.....