


T.8N., R.4W., W.M.

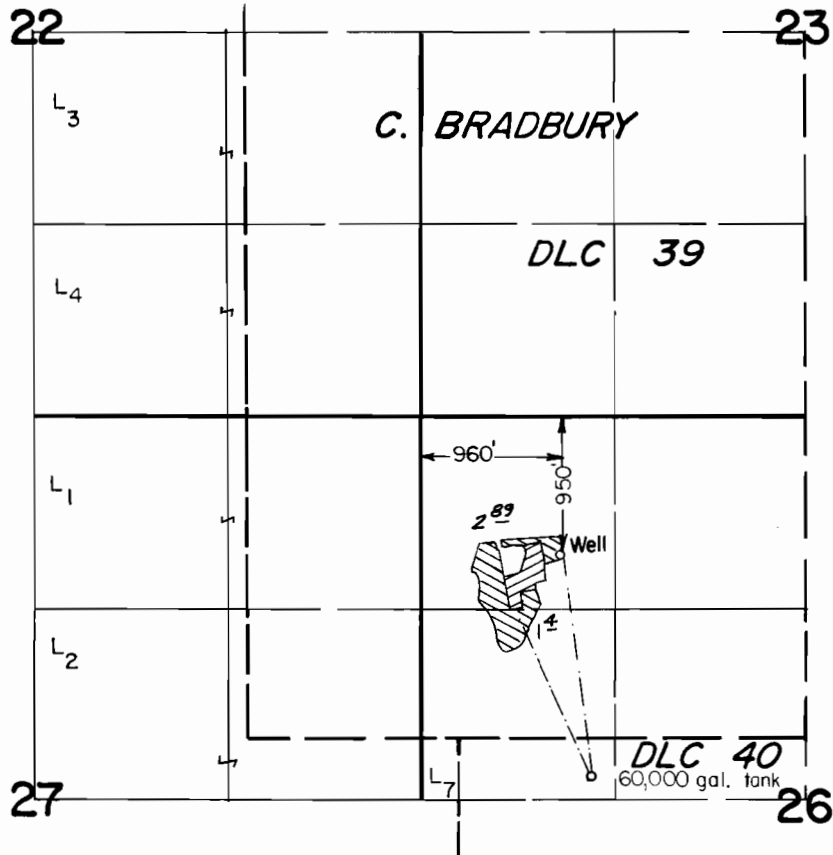

Scale: 1" = 1320'

FINAL PROOF SURVEY UNDER



Irrigation



General School Use

Application No. G-6940. Permit No. G-6456....
IN NAME OF

COLUMBIA COUNTY ADMINISTRATIVE SCHOOL DISTRICT 5-J

Surveyed AUG. 12. 1986., by T. Warren.....

41009-280-196 D
3/2/87 TMW