


G-6582

57851

# T.13S.,R.31E.,W.M.

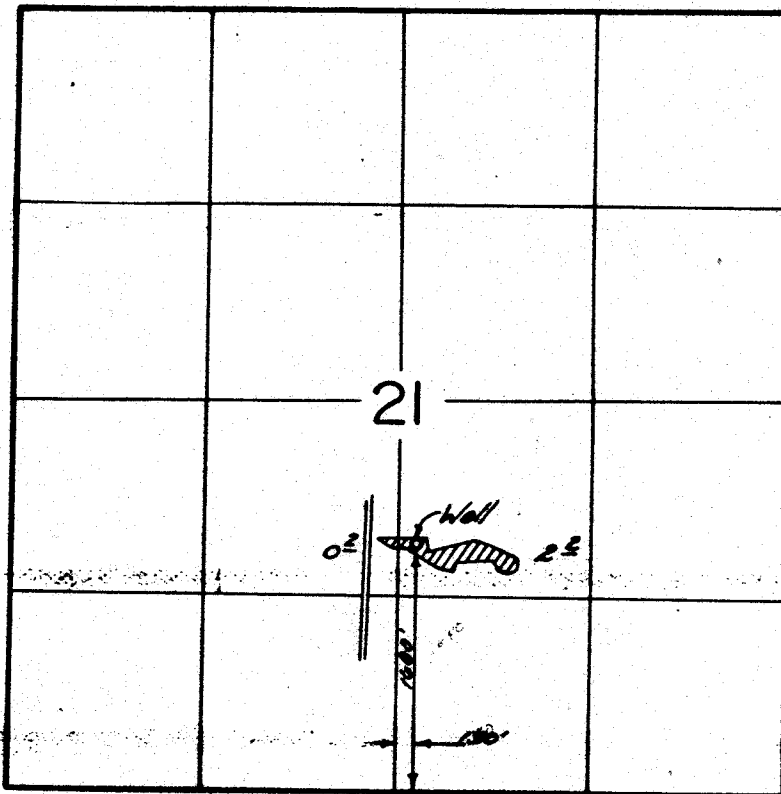

## FINAL PROOF SURVEY UNDER

Application No. G-7131 Permit No. G-6582

IN NAME OF

### AUGUST H. STEVENSON

Surveyed JUNE 17, 1980, by *Johnson*