


P-39285
R-6306
57853
57852

T.13S., R.31E., W.M.

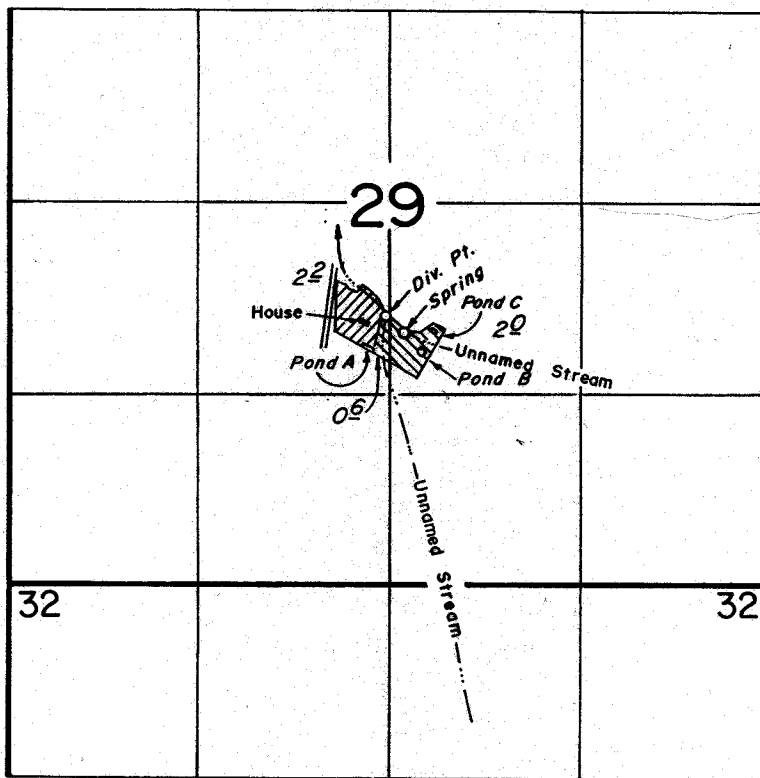

Diversion Points Located: Unnamed Stream - 1850' N. & 30' W.; Spring - 1730' N. & 90' E.; Pond A - 1650' N. & 130' W.; Pond B - 1650' N. & 220' E.; Pond C - 1750' N. & 300' E., all from the S.1/4 corner Section 29

 PRIMARY
 SUPPLEMENTAL

FINAL PROOF SURVEY UNDER

R-52167 R-6306
Application No. 52168 Permit No. 39285

IN NAME OF
AUGUST H. STEVENSON

Surveyed JUNE 17, 1980, by *A. H. Stevenson*