

57854

RECEIVED


AUG 13 1975

WATER RESOURCES DEPT.
SALEM, OREGON

RECEIVED

AUG 13 1975

WATER RESOURCES DEPT.
SALEM, OREGON

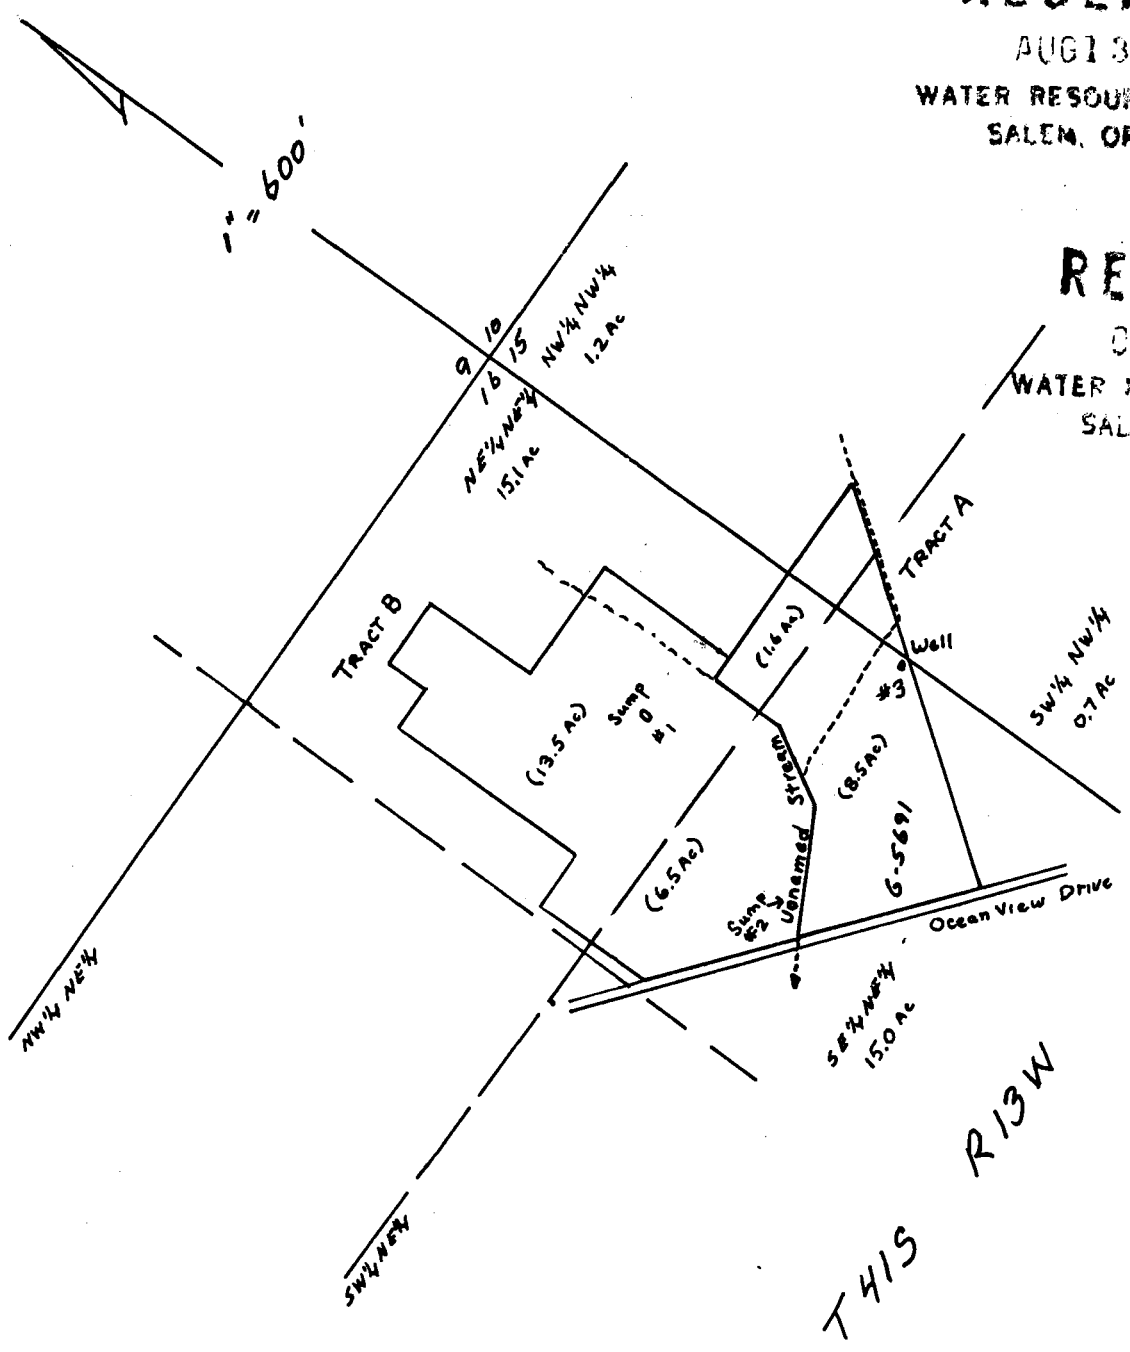

P.O.D. #1 located 1060' South and 635' West from the NE corner of Sec 16.
 P.O.D. #2 located 1770' South and 905' West from the NE corner of Sec 16.
 P.O.D. #3 located 1640' South and 40' West from NE corner of Sec 16.

Application No. G-7069
 Permit No. G 6851

G-6851