


# T. 10 S., R. 2 W., W.M.

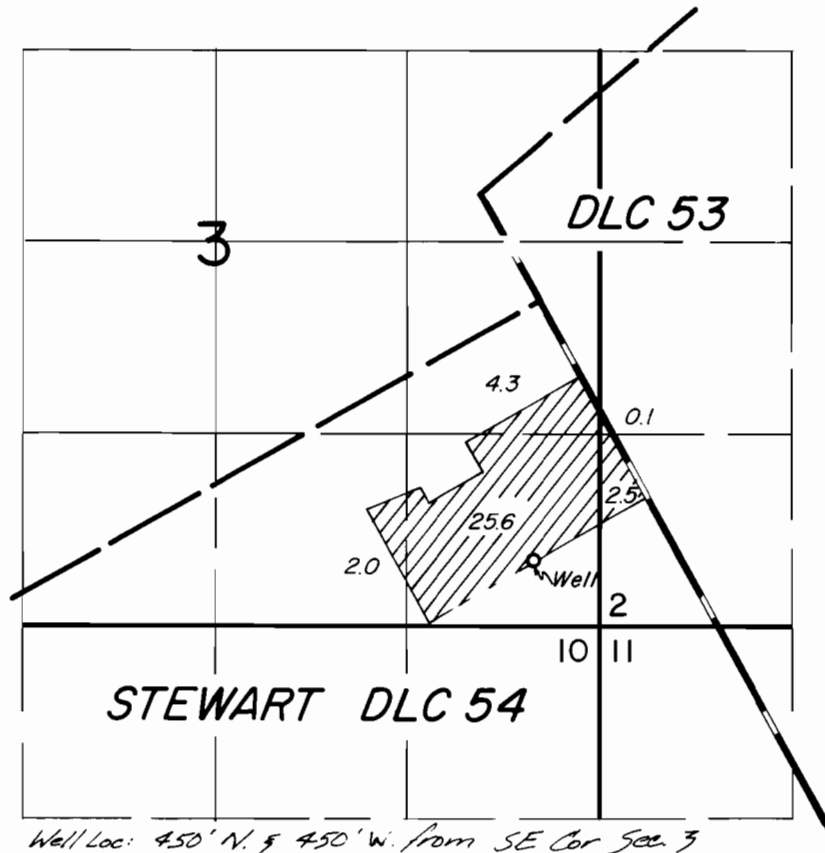

## FINAL PROOF SURVEY UNDER

Application No. G-7680 Permit No. G-7109  
IN NAME OF

WALTER R. MILLER

Surveyed MAY 1, 1980, by *W. B. Miller*