


T.14S., R. 48 & 5W., W.M.

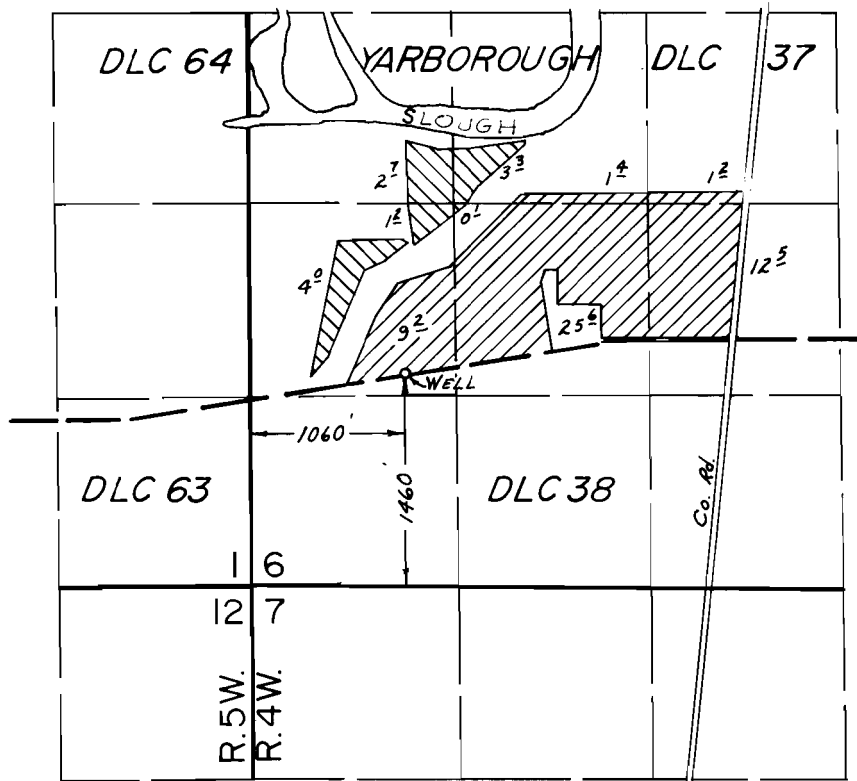

 JENSEN
 CLEMENS

FINAL PROOF SURVEY
UNDER

Application No. G-7914... Permit No. G-7309...
IN NAME OF

CHARLES F. JENSEN

Surveyed JUNE 30, 1980, by S.C. BROWN