


T. 3S., R. 39E., W. M.

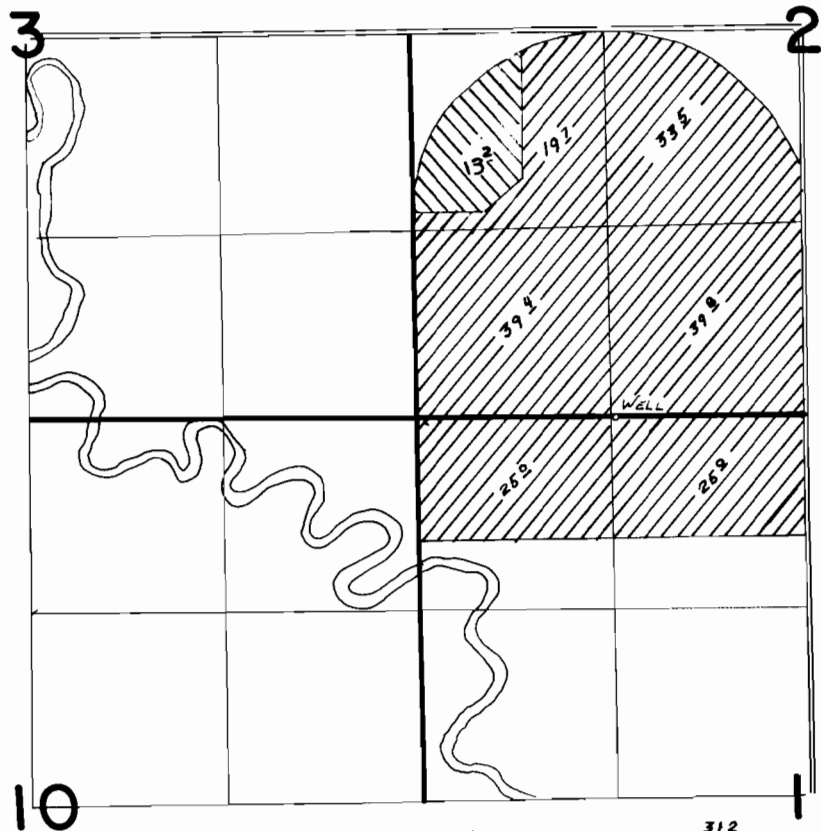

WELL LOCATION; 0' NORTH AND 1350' EAST FROM SEC. COR. $\frac{312}{1011}$

FINAL PROOF SURVEY
UNDER



SUPPLEMENTAL

PRIMARY

Application No. **G-8067** Permit No. **G-7350**
IN NAME OF

EVERETT L. HAMANN

Surveyed ~~August 24~~ 1983, by **V.L. CHURCH**