


T. 6S., R. 1W., W.M.

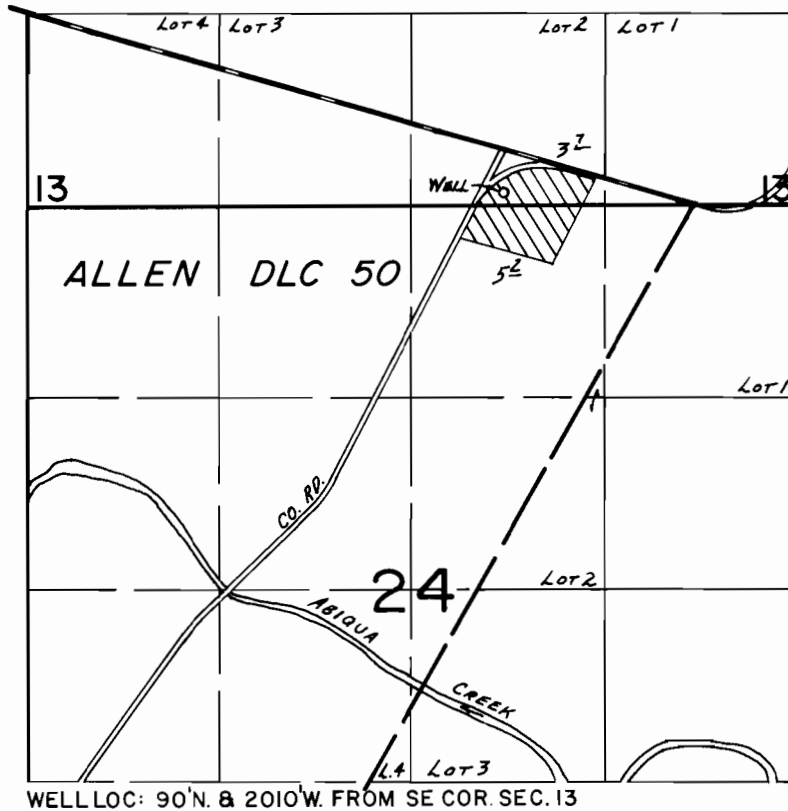

**FINAL PROOF SURVEY**  
UNDER

Application No. G-8021 Permit No. G-7424.....  
IN NAME OF

LAVERN C. TOTLAND.....

Surveyed May 13..... 1980, by B.W. BISHOP.....