


# T. 36 S., R. 1 W., W.M.

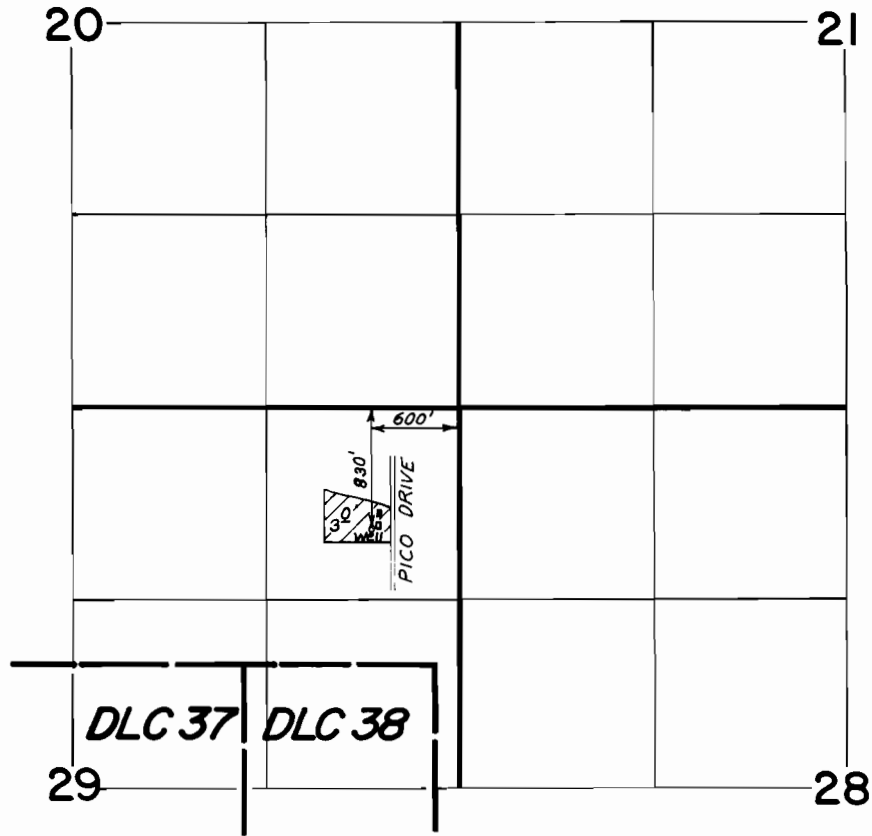

SCALE: 1" = 1320'

## FINAL PROOF SURVEY UNDER

Application No. G-8031 Permit No. G-7432  
IN NAME OF

DAVID E. GEORGE

Surveyed JUNE 14, 1984, by TIM W. BURKS