


T. 24S., R. 34E., W. M.

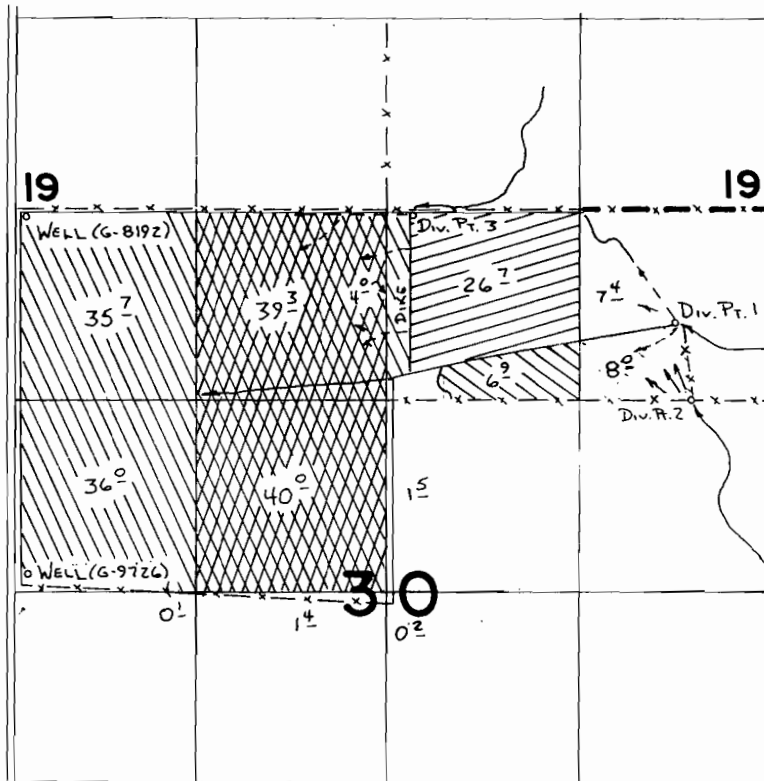

SCALE 1" = 1320'

Div. Pt. 1 Loc: 780'S. & 670'W. }
 Div. Pt. 2 Loc: 1320'S. & 550'W. } FROM NE COR. SEC 30
 Div. Pt. 3 Loc: 30'S. & 2460'W. }

WELL (G-8192) Loc: 60'S. & 2490'W. FROM N 1/4 COR. SEC 19

WELL (G-9726) Loc: 2510'S. & 2470'W. FROM N 1/4 COR. SEC. 19

FINAL PROOF SURVEY

UNDER

61246

46451

G-8779

G-8192

Application No. G-10611.. Permit No. G-9726.

IN NAME OF

JULIAN R. ZIMMERMAN

Surveyed 7-30-1987, by V.L.C.

-  Div. Pt. 1 & 2 PER. 46451
-  Div. Pt. 2 PER. 46451
-  Div. Pt. 1, 2 & 3 PER. 46451
G-8192
-  G-9726