


T. 24S., R. 34E., W. M.

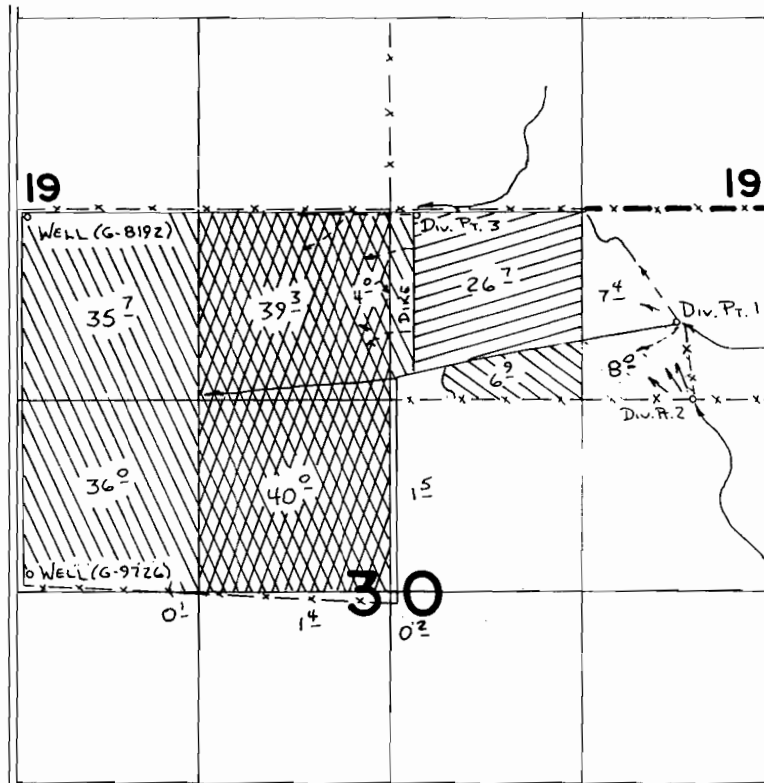

Div. Pt. 1 Loc: 780'S. & 670'W.  
 Div. Pt. 2 Loc: 1320'S. & 550'W.  
 Div. Pt. 3 Loc: 30'S. & 2460'W. } From NE Cor. Sec 30  
 WELL (G-8192) Loc: 60'S. & 2490'W. From N¼ Cor. Sec 19  
 WELL (G-9726) Loc: 2510'S. & 2470'W. From N¼ Cor. Sec. 19

# FINAL PROOF SURVEY UNDER

61246

G-8779

Application No. G-10611 Permit No. G-9726

IN NAME OF

JULIAN R. ZIMMERMAN

Surveyed 7-30 1987, by V.L. Church

-  Div. Pt. 1 & 2 PER. 46451
-  Div. Pt. 2 PER. 46451
-  Div. Pt. 1, 2 & 3 PER. 46451  
G-8192
-  G-9726