


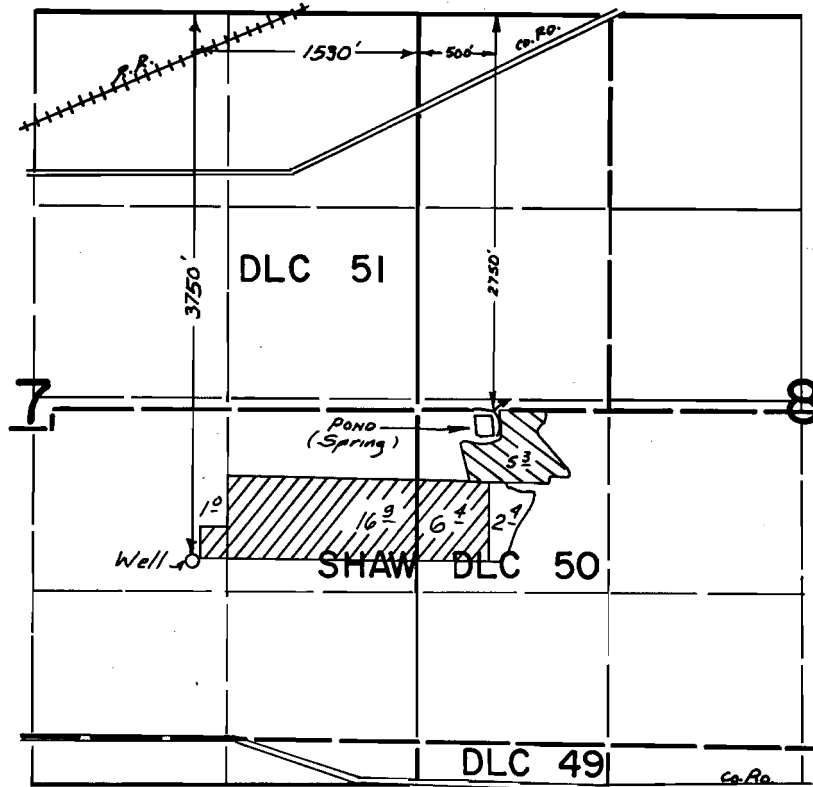

T.7S.,R.1W.,W.M.



FINAL PROOF SURVEY

UNDER

G-8894	G-8225	
R-55358	R-6613	
Application No. 55359	Permit No. 41799	

IN NAME OF

.....CLIFFORD HERR.....

Surveyed Oct. 29, 1981, by S.C. BROWN.....

May 31, 1984 B. BISHOP