


T.7S.,R.1W.,W.M.

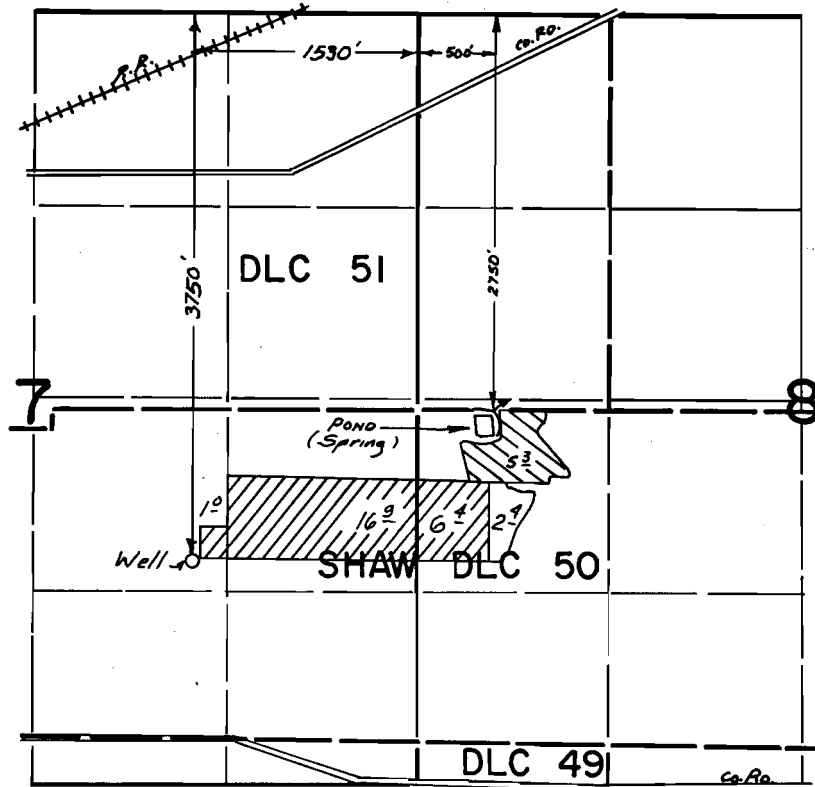

FINAL PROOF SURVEY

UNDER

G-8894

G-8225

R-55358

R-6613

Application No. 55359 Permit No. 41799

IN NAME OF

CLIFFORD HERR

Surveyed Oct. 29 1981., by S. C. BROWN.....

May 31, 1984

B. BISHOP