


T.3N.R.3W.W.M.

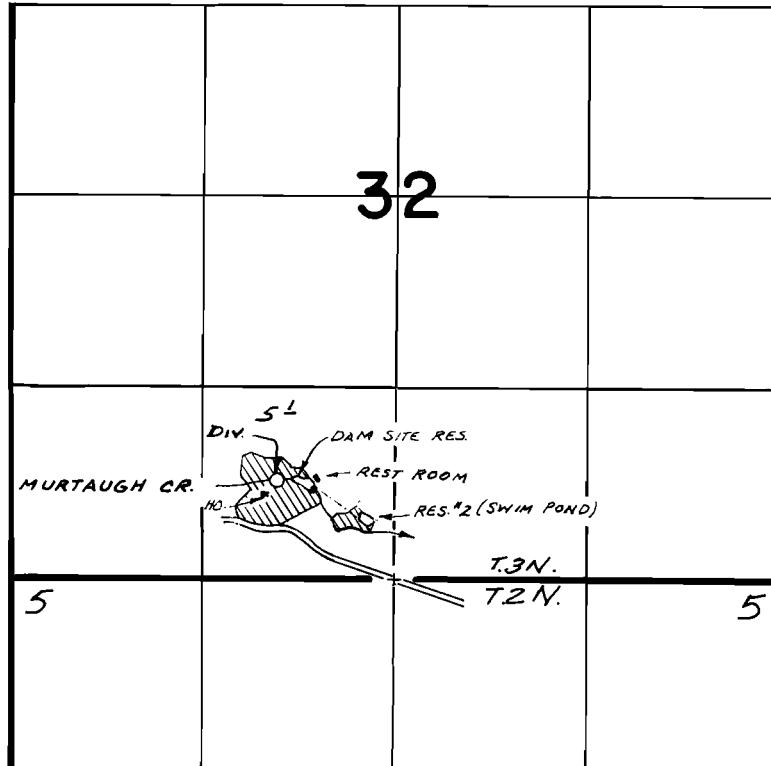

DIV. PTS. LOC: CREEK-680'N. & 820'W ; RES. - 600'N. & 550'W., BOTH FROM S $\frac{1}{4}$ COR. SEC. 32

FINAL PROOF SURVEY
UNDER

Application No. *R-52802* ~~52728~~ Permit No. *R-6417* ~~40289~~
IN NAME OF

.....*RICHARD C. EARLE*.....

Surveyed *MAY 29 1980*, by *R. MUCKEN*