


T.3N.R.3W.W.M.

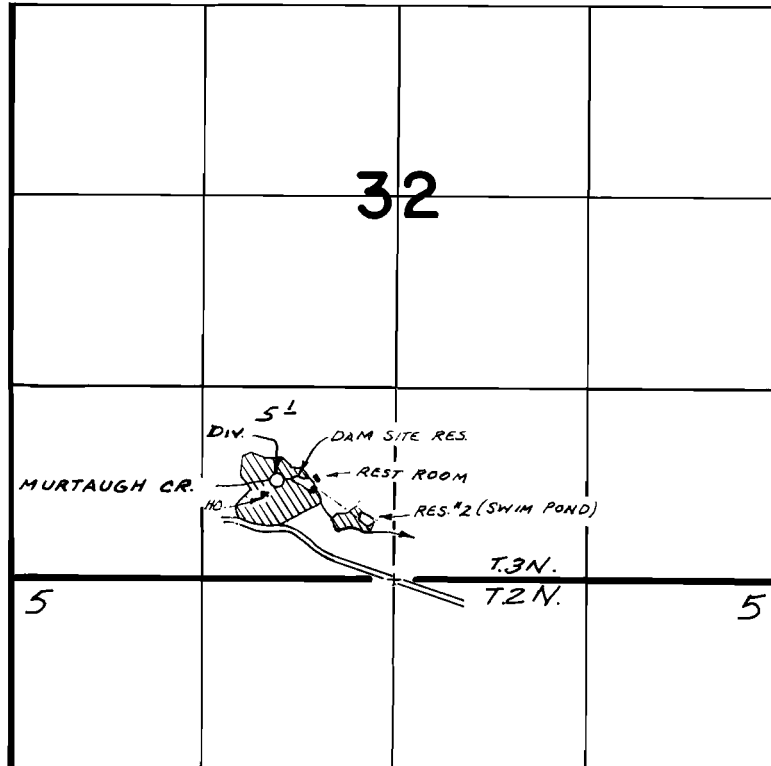

DIV. PTS. LOC: CREEK-680'N. & 820'W ; RES. - 600'N. & 550'W., BOTH FROM S $\frac{1}{4}$ COR. SEC. 32

FINAL PROOF SURVEY
UNDER

Application No. R-52802 ~~52728~~ Permit No. R-6417 ~~40289~~
IN NAME OF

.....RICHARD C. EARLE.....

Surveyed MAY 29 1980, by R. MUCKEN