


T.4 S. R.5 W. W.M.

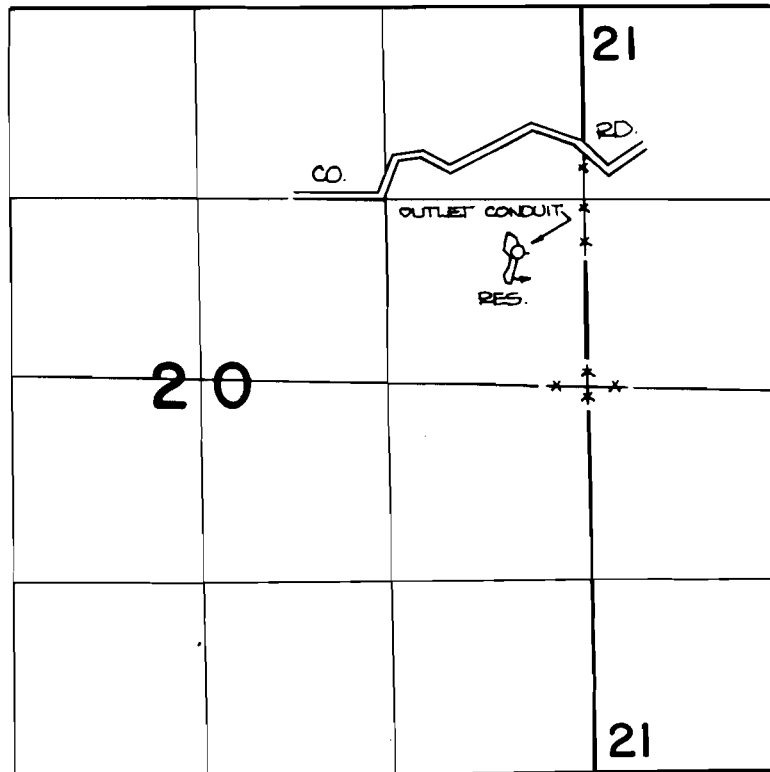

OUTLET CONDUIT IS LOCATED 940' N. AND 460' W. FROM
THE S.E. CORNER OF THE S.E. 1/4 OF THE NE 1/4
OF SECTION 20.

FINAL PROOF SURVEY
UNDER

R-56581 R-6741
Application No. 56.7.8.6. Permit No. 4.2.5.21.....
IN NAME OF

JAY SHUE

Surveyed OCT. 5..... 19.83, by P. Pagano.....