


T.8S. R.5 & 6W. WM.

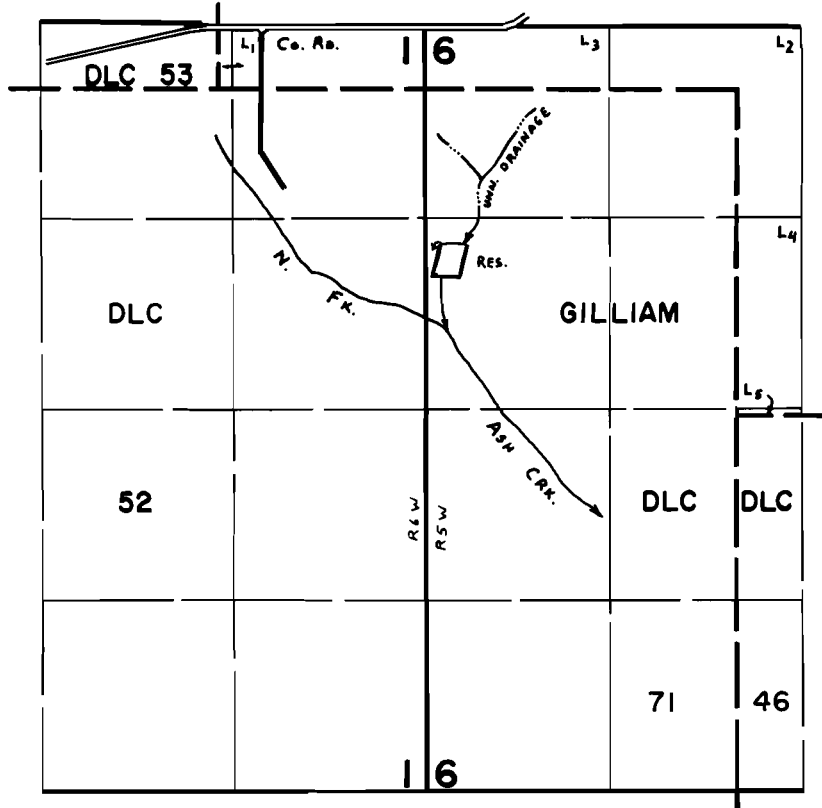

DAM LOC: 1280' S. & 2030' W. fr. N.E. COR. GILLIAM D.L.C. 71.

FINAL PROOF SURVEY UNDER

R-56322

R-7149

Application No. 57222... Permit No. 42917.....

IN NAME OF

STAFFORD E. & PHYLLIS N. STEARNS

Surveyed June...7... 19.79., by C.L. HUGHES.....