


T. 4S., R. 3E., W. M

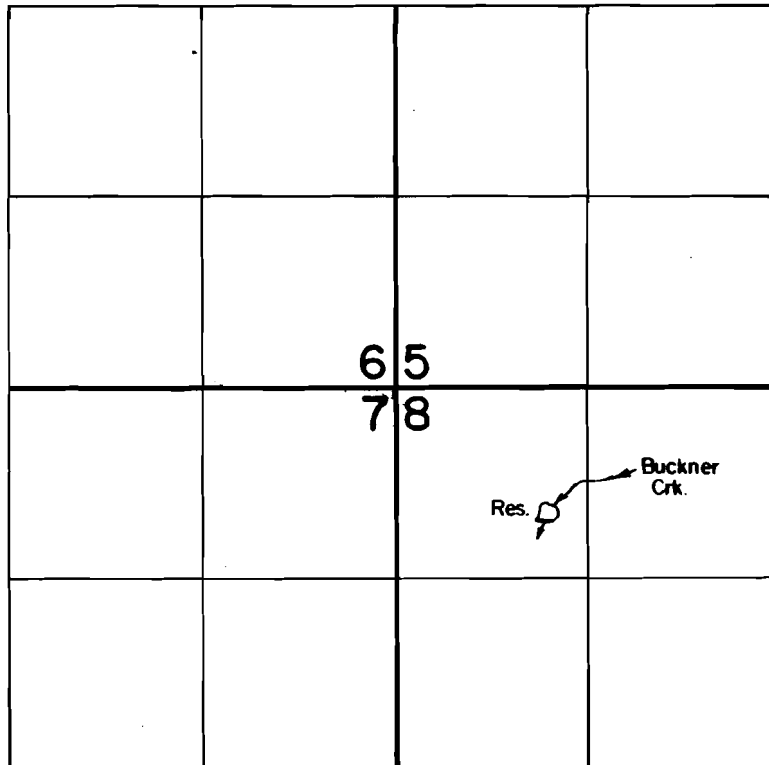

Dam Loc. : 920' S. & 1000' E. from NW. Cor. Sec. 8.

Scale : 1" = 1320'

FINAL PROOF SURVEY
UNDER

R-60979 R-8321
Application No. 60978 Permit No. 46153.....
IN NAME OF

.....WALTER H. YOREE.....

Surveyed JULY 10, 1986., by T. Warren.....