


T. 1N., R. 10E., W. 1M.

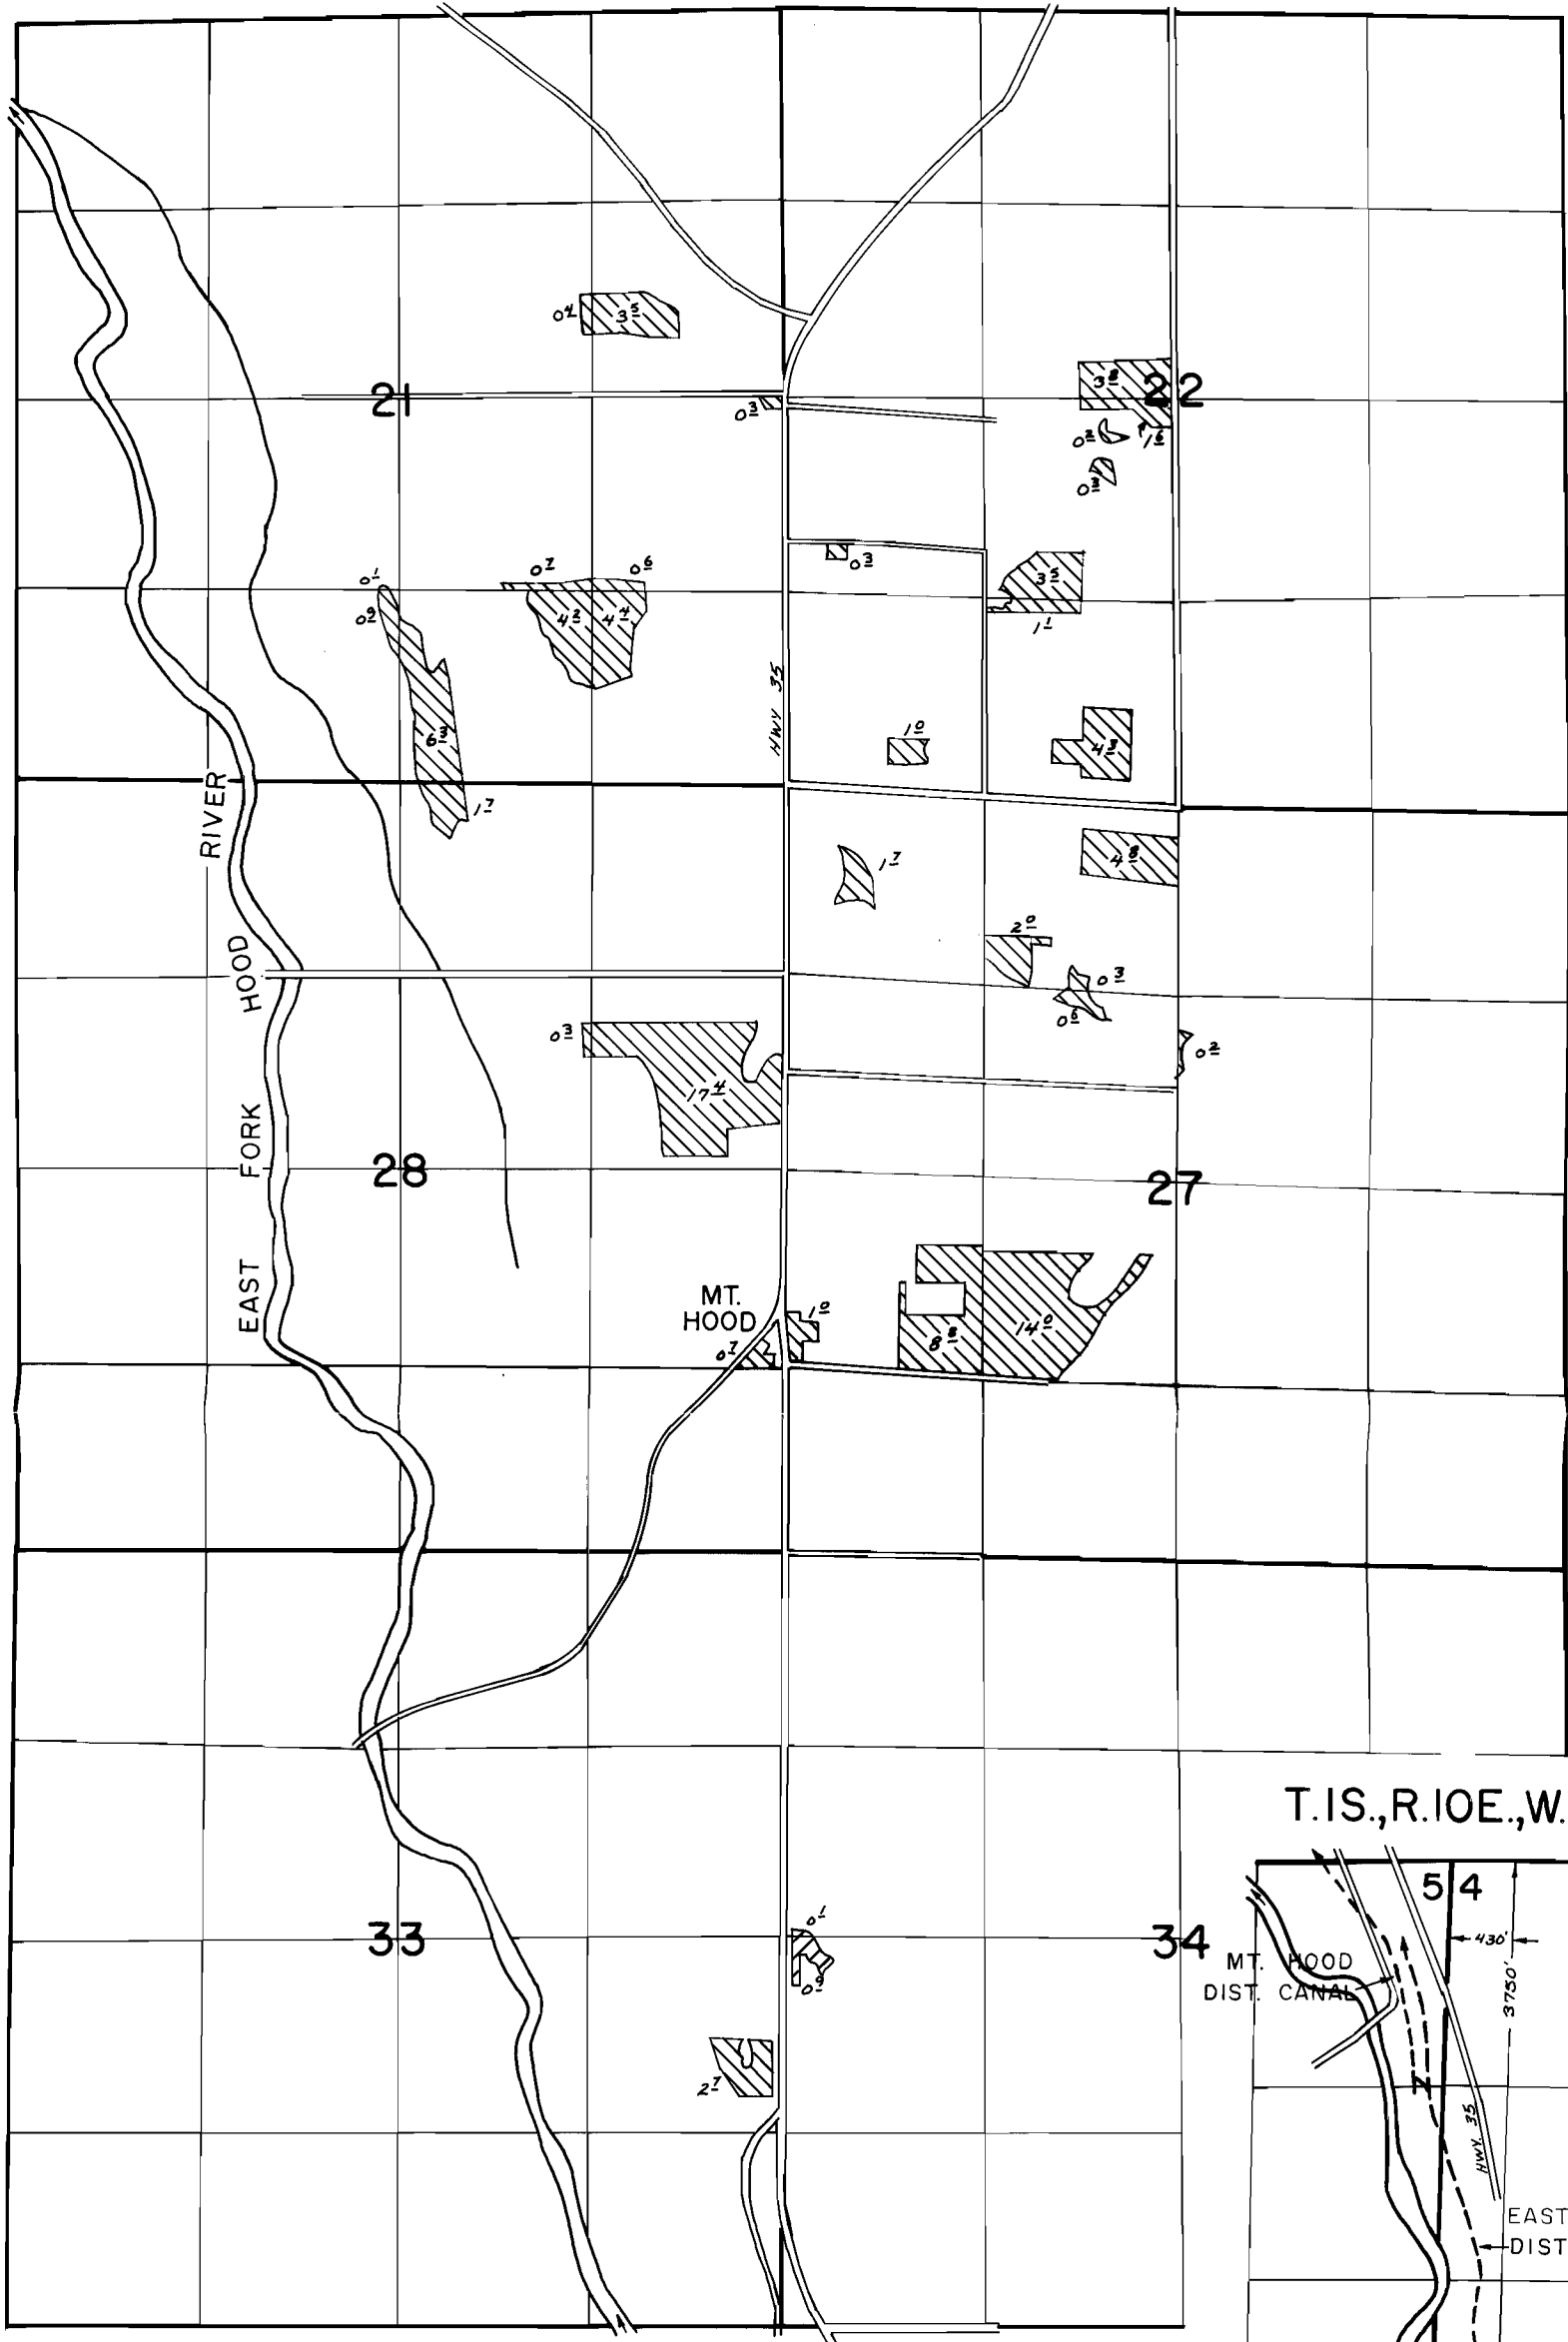

 - PRIMARY
 - SUPPLEMENTAL

FINAL PROOF SURVEY
UNDER

Transfer No. 3645
 Application No. 39593 Permit No. 29613
 IN NAME OF
MOUNT HOOD IRRIGATION DISTRICT

Surveyed April 18-25, 1980 by R. G. Mucken.

T. 1S., R. 10E., W. 1M.

