


T.9&10S.,R.2W.,W.M.

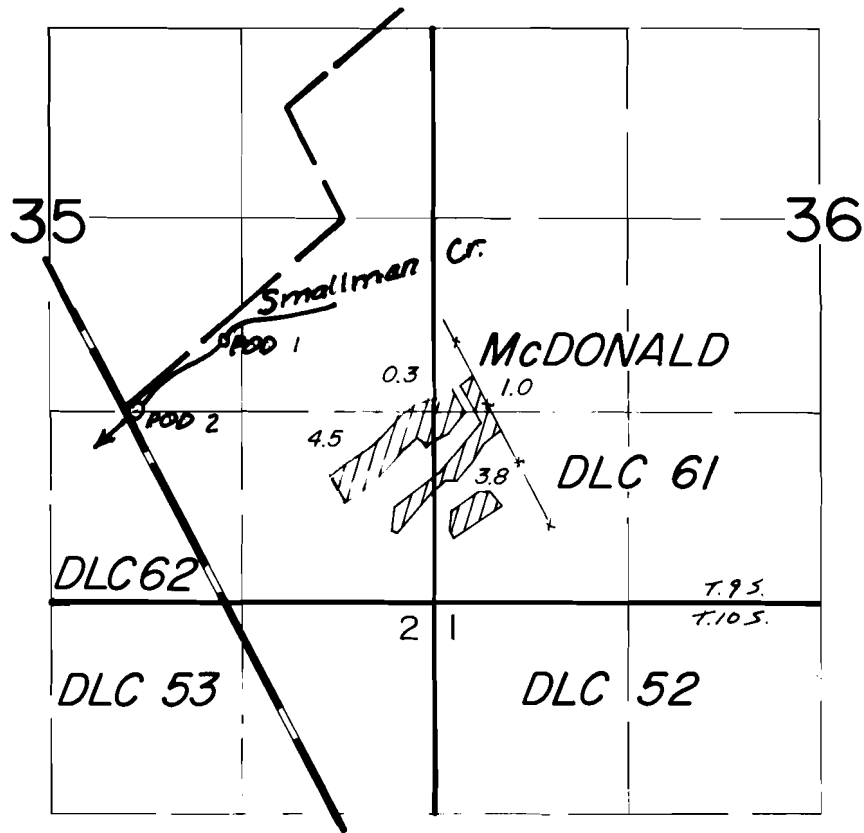

- 1- 4700' N & 1500' W FROM SW COR DLC 52
- 2- 0.3 CHAIN N & 0.6 CHAIN E FROM WNW COR DLC 61

FINAL PROOF SURVEY UNDER

Application No. 55732. Permit No. 41742.....

IN NAME OF

WALTER R. MILLER

Surveyed JULY 3, 1979, by *J. Brown*