


T.26S. R.4W. W.M.

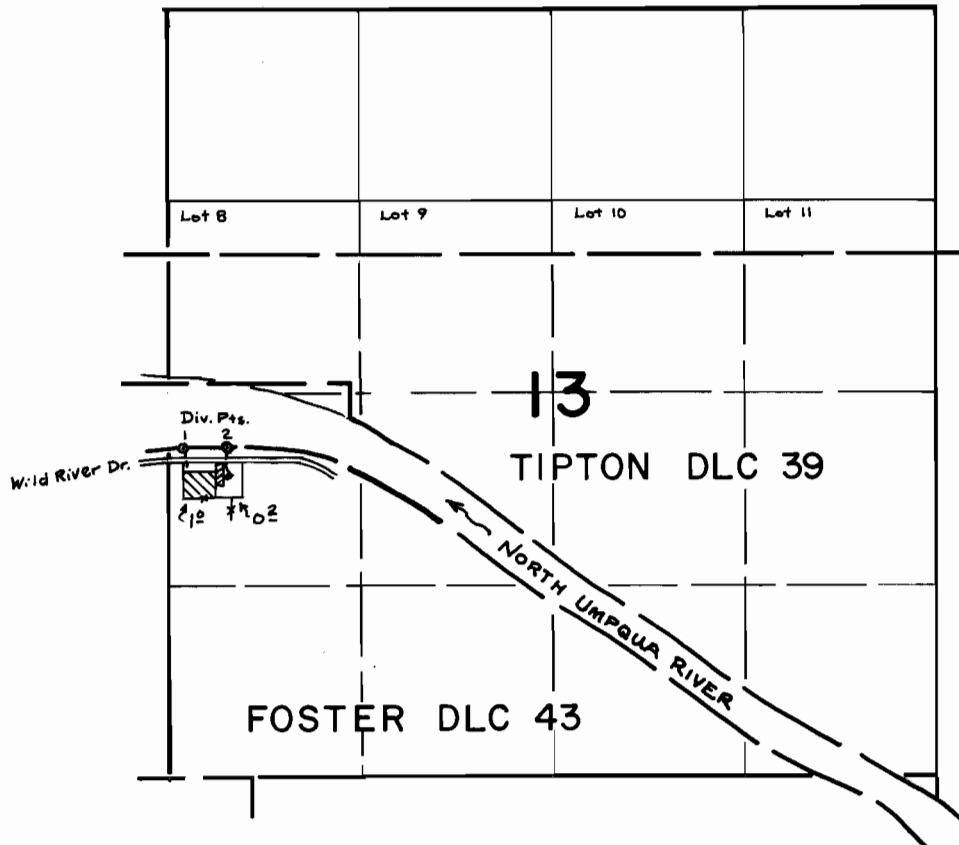

Div. Pts. Located: 1- 2270' N  $\frac{1}{4}$  100' E, 2- 2270' N  $\frac{1}{4}$  420' E, from the SW Cor. of Sec. 13

SCALE: 4" = 1 mile

**FINAL PROOF SURVEY**  
UNDER

Application No. 50995 Permit No. 38490

IN NAME OF  
JAY E. & GERTRUDE J. EATON

WILLIAM G. KINMAN

Surveyed April 25 1979, by S. Donaldson