


T. 6S., R. 6W., W.M.

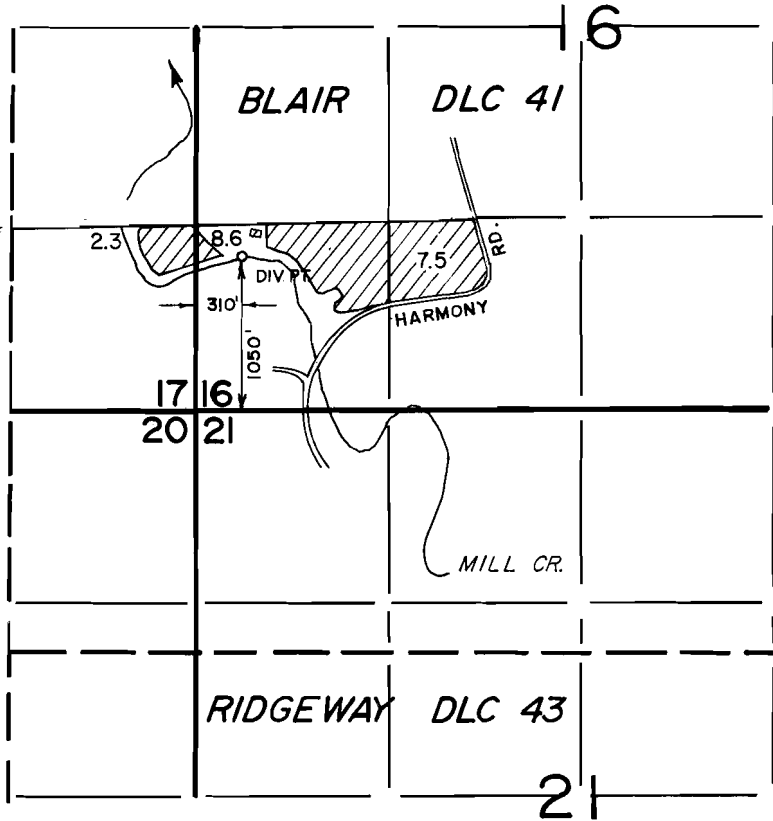

**FINAL PROOF SURVEY**  
UNDER

Application No. 53280... Permit No. 39538.....  
IN NAME OF

**MARK A. MILLIKAN**

Surveyed JUNE 1..... 19.79., by R.G. MUCKEN.....