


T.4N. R.2W.W.M.

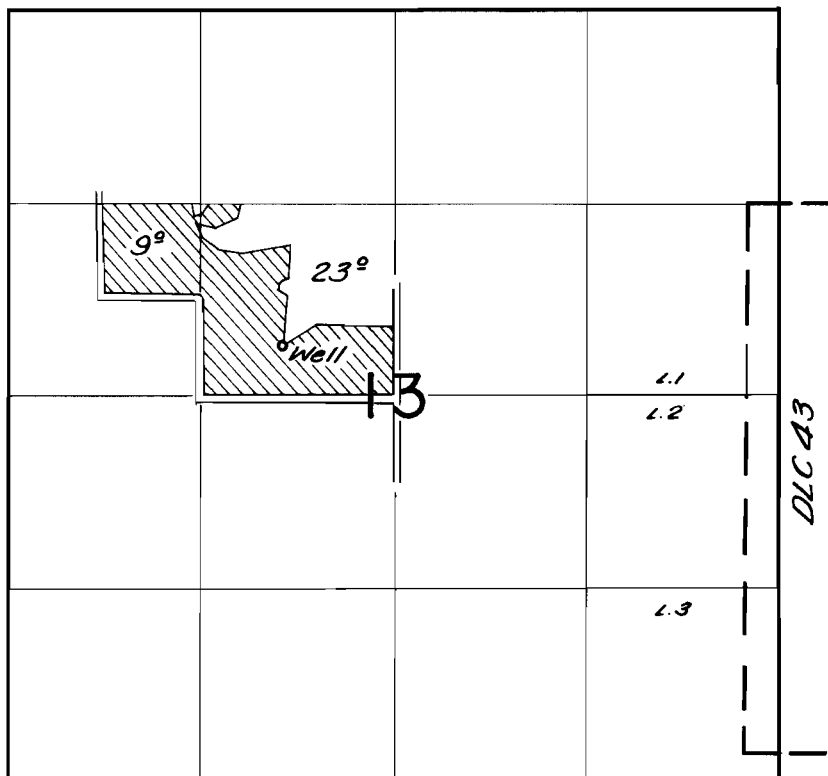

FINAL PROOF SURVEY
UNDER

Application No. *G-1565* Permit No. *G-1447*
IN NAME OF

PAUL J. DE SHAZER

Surveyed *July 19* 1960, by *C. O. Baith*