90684

T. 37 S., R. 7&8 W., W.M.

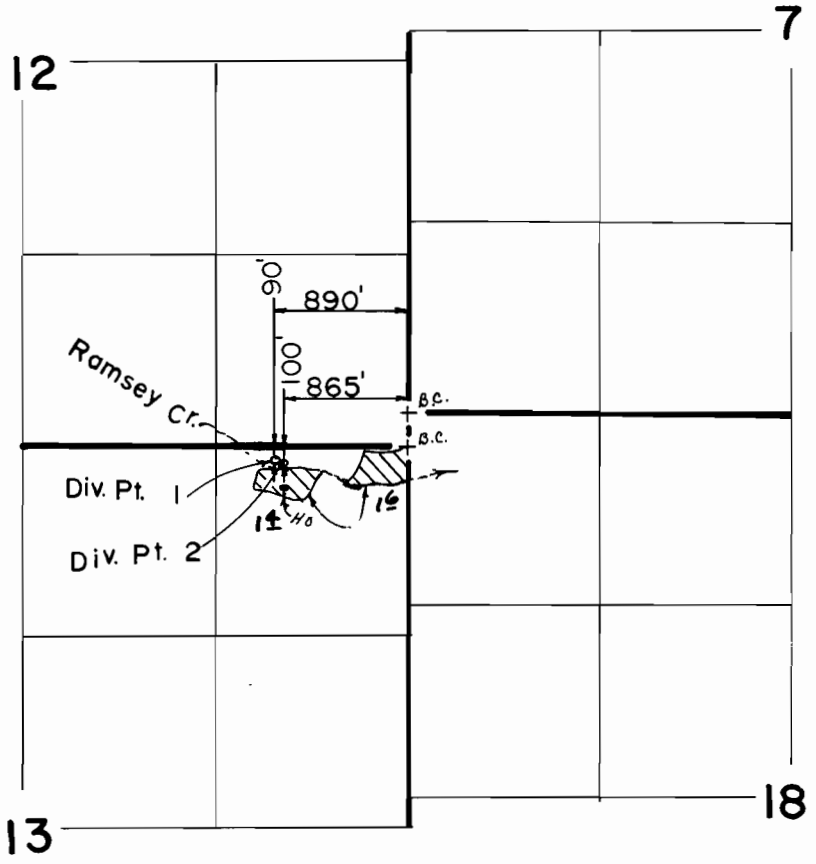

FINAL PROOF SURVEY

UNDER

Application No. 53795 Permit No. 40451

IN NAME OF

JOHN A. WITTICH

Surveyed MAY 19 19 88, by B. S. JAMES

41033-179-97R LMJ