


T. 33 S., R. 6 W., W. M.

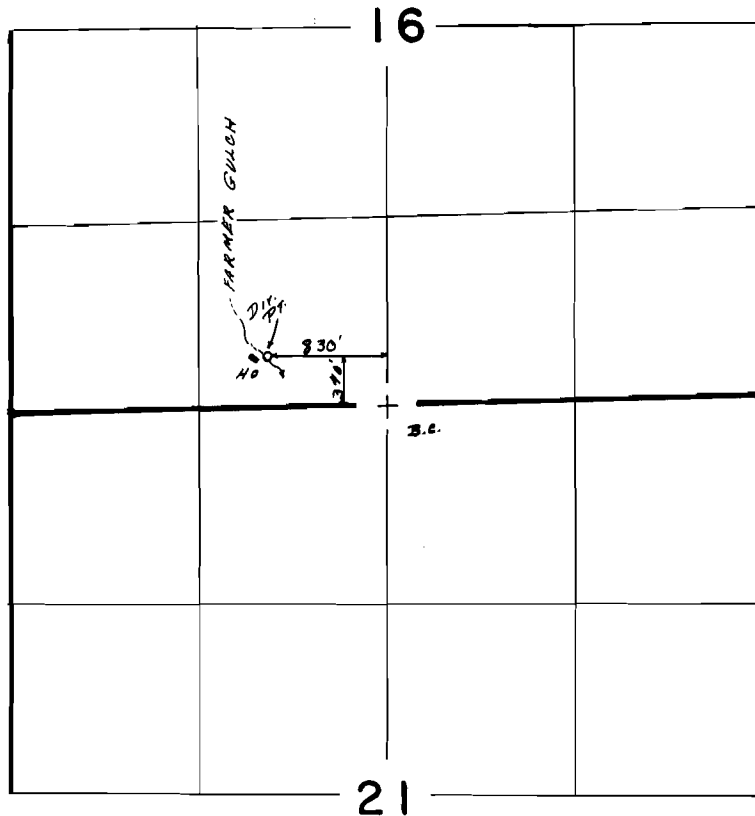

Scale: 1" = 1320'

FINAL PROOF SURVEY
UNDER

Application No. 56173 Permit No. 42143
IN NAME OF

WILLIAM DOUGLAS &/OR JO ANN ELAINE NORDSTROM

Surveyed APR. 30. 1986, by B. S. JAMES.