


T.29S. R.5W. W.M.

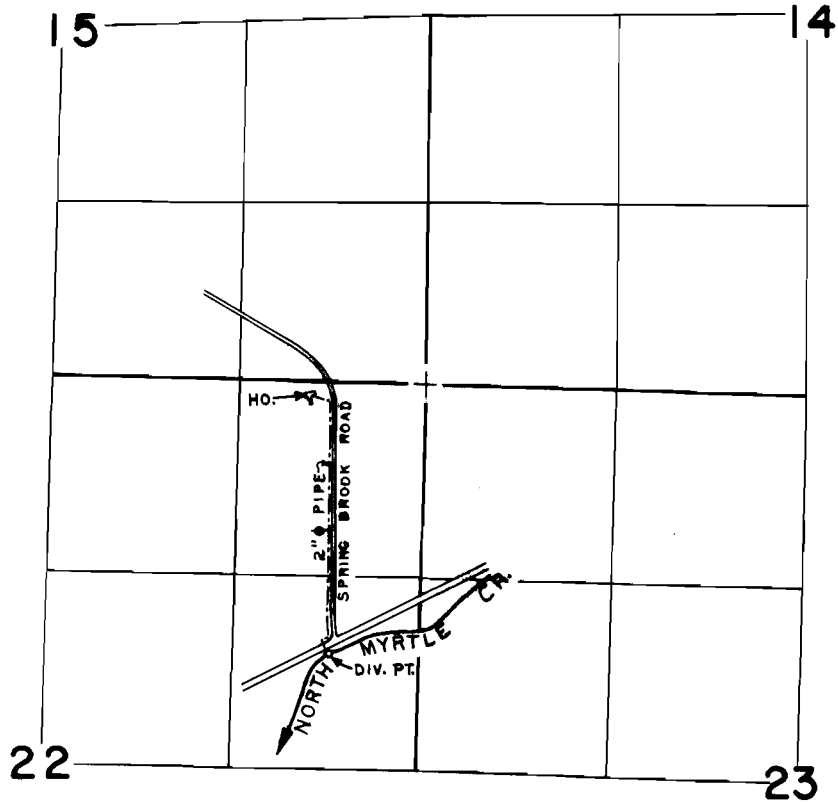

DIV. PT. LOCATED 1,860' S. & 680' W. FROM COR. SEC. 14, 15, 22, & 23

SCALE: 4" = 1 mile

FINAL PROOF SURVEY
UNDER

Application No. 56283. Permit No. 42160.....
IN NAME OF

NICHOLAS COUNTS

Surveyed DEC. 20, 1983, by L. CASHION.