



T. 33 S., R. 2 E., W.M.

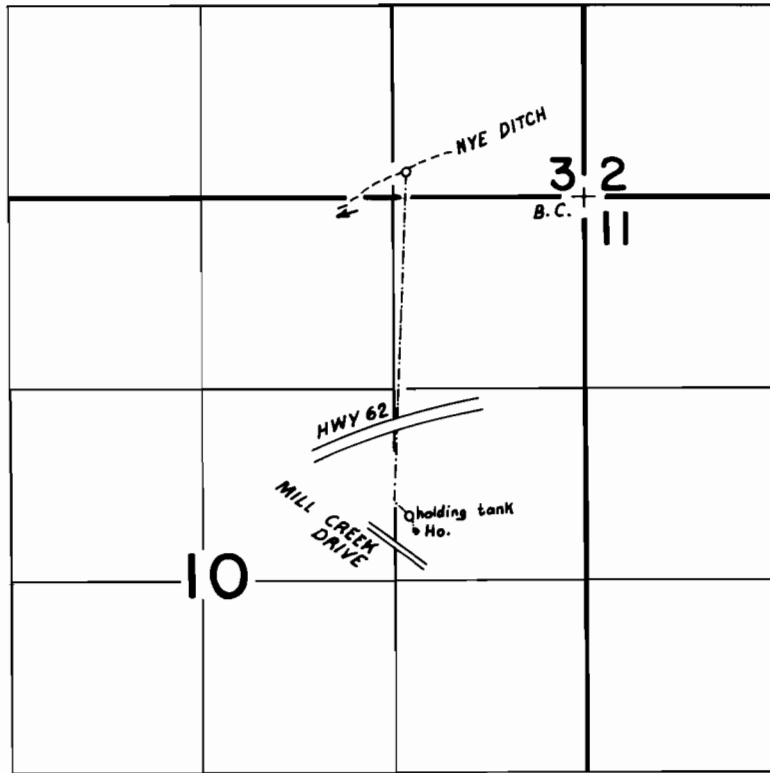

SCALE: 1" = 1320'

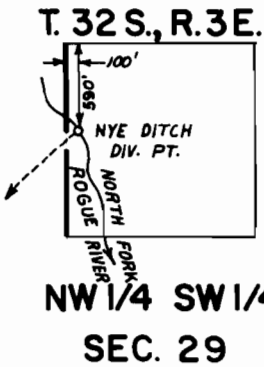

**FINAL PROOF SURVEY**  
UNDER

Application No. 57859 Permit No. 43622...  
IN NAME OF

WILLIAM D. &/or FLORENCE E. BARNES

Surveyed MAY 25 1983, by B.S. JAMES...